


GENERALIZED SECTION ALONG A-A'

Horizontal Scale 1" = 1 mile

LEGEND

- Quaternary alluvium (clays, silts, sands & gravels)
- Tertiary Fort Union Formation (sandstones, claystones, shales, lignite)
- Tertiary Lance Formation (sandstone & shale)
- Cretaceous Bearpaw Shale Formation (dark gray shale)

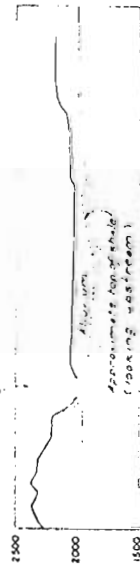

VALLEY SECTION B-B'


Horizontal Scale 1 inch = 1 mile (approx.)

MISSOURI RIVER IMPROVEMENT
FORT PECK DAM
GEOLOGIC MAP OF MISSOURI RIVER
VALLEY FROM FORT PECK DAM
TO MONTANA STATE LINE

AM 1 SHEETS
FORT PECK DAM, MONTANA
REVISION NO. 1
DATE 1933

7750 x 2-36

NOTE: Aerial geologic map adopted from Geologic Map of Montana published by Montana Bureau of Mines and Geology, 1933.

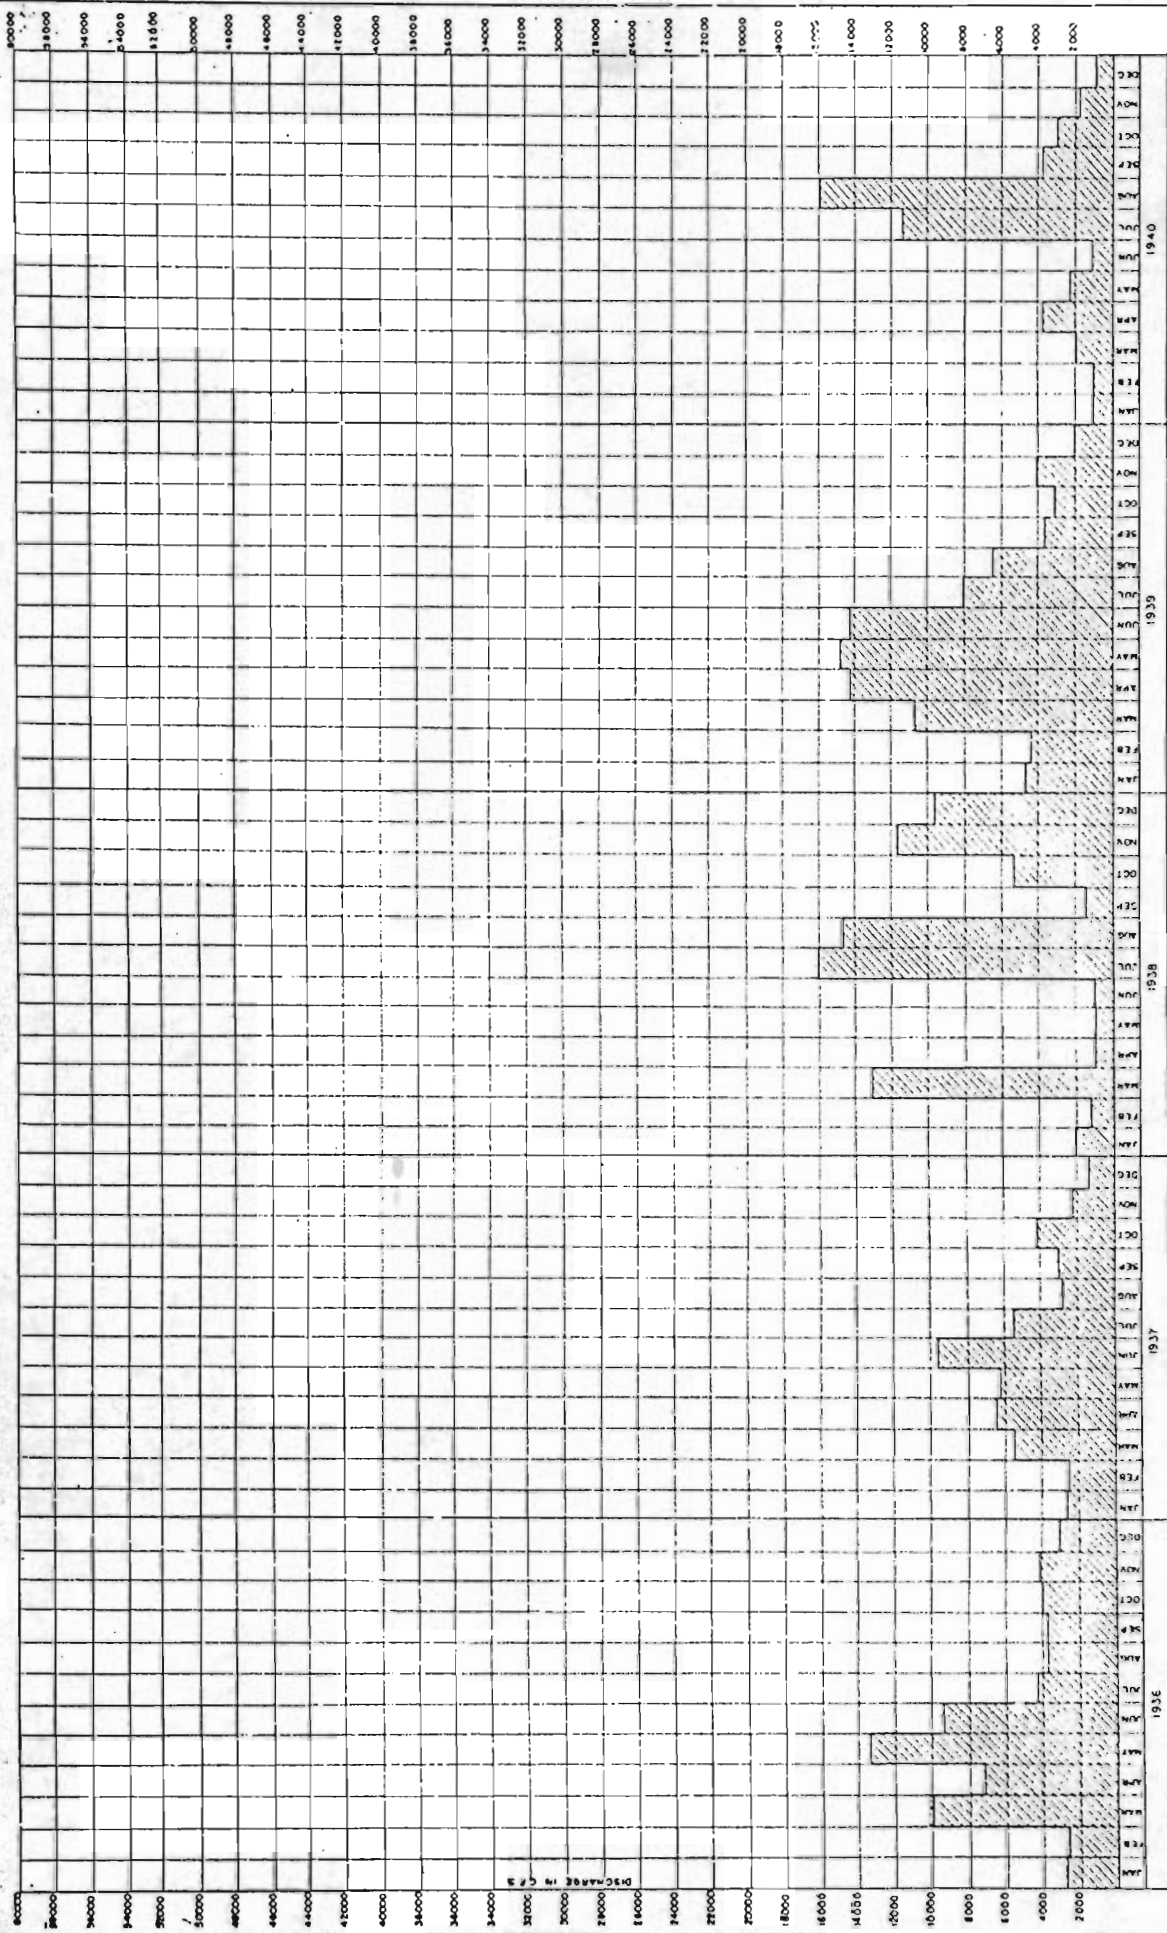

MISSOURI RIVER IMPROVEMENT
FORT PECK DAM
MEAN MONTHLY DISCHARGE

TUNNEL DISCHARGE


7250 4-2-142

REVISIONS



CORPS OF ENGINEERS

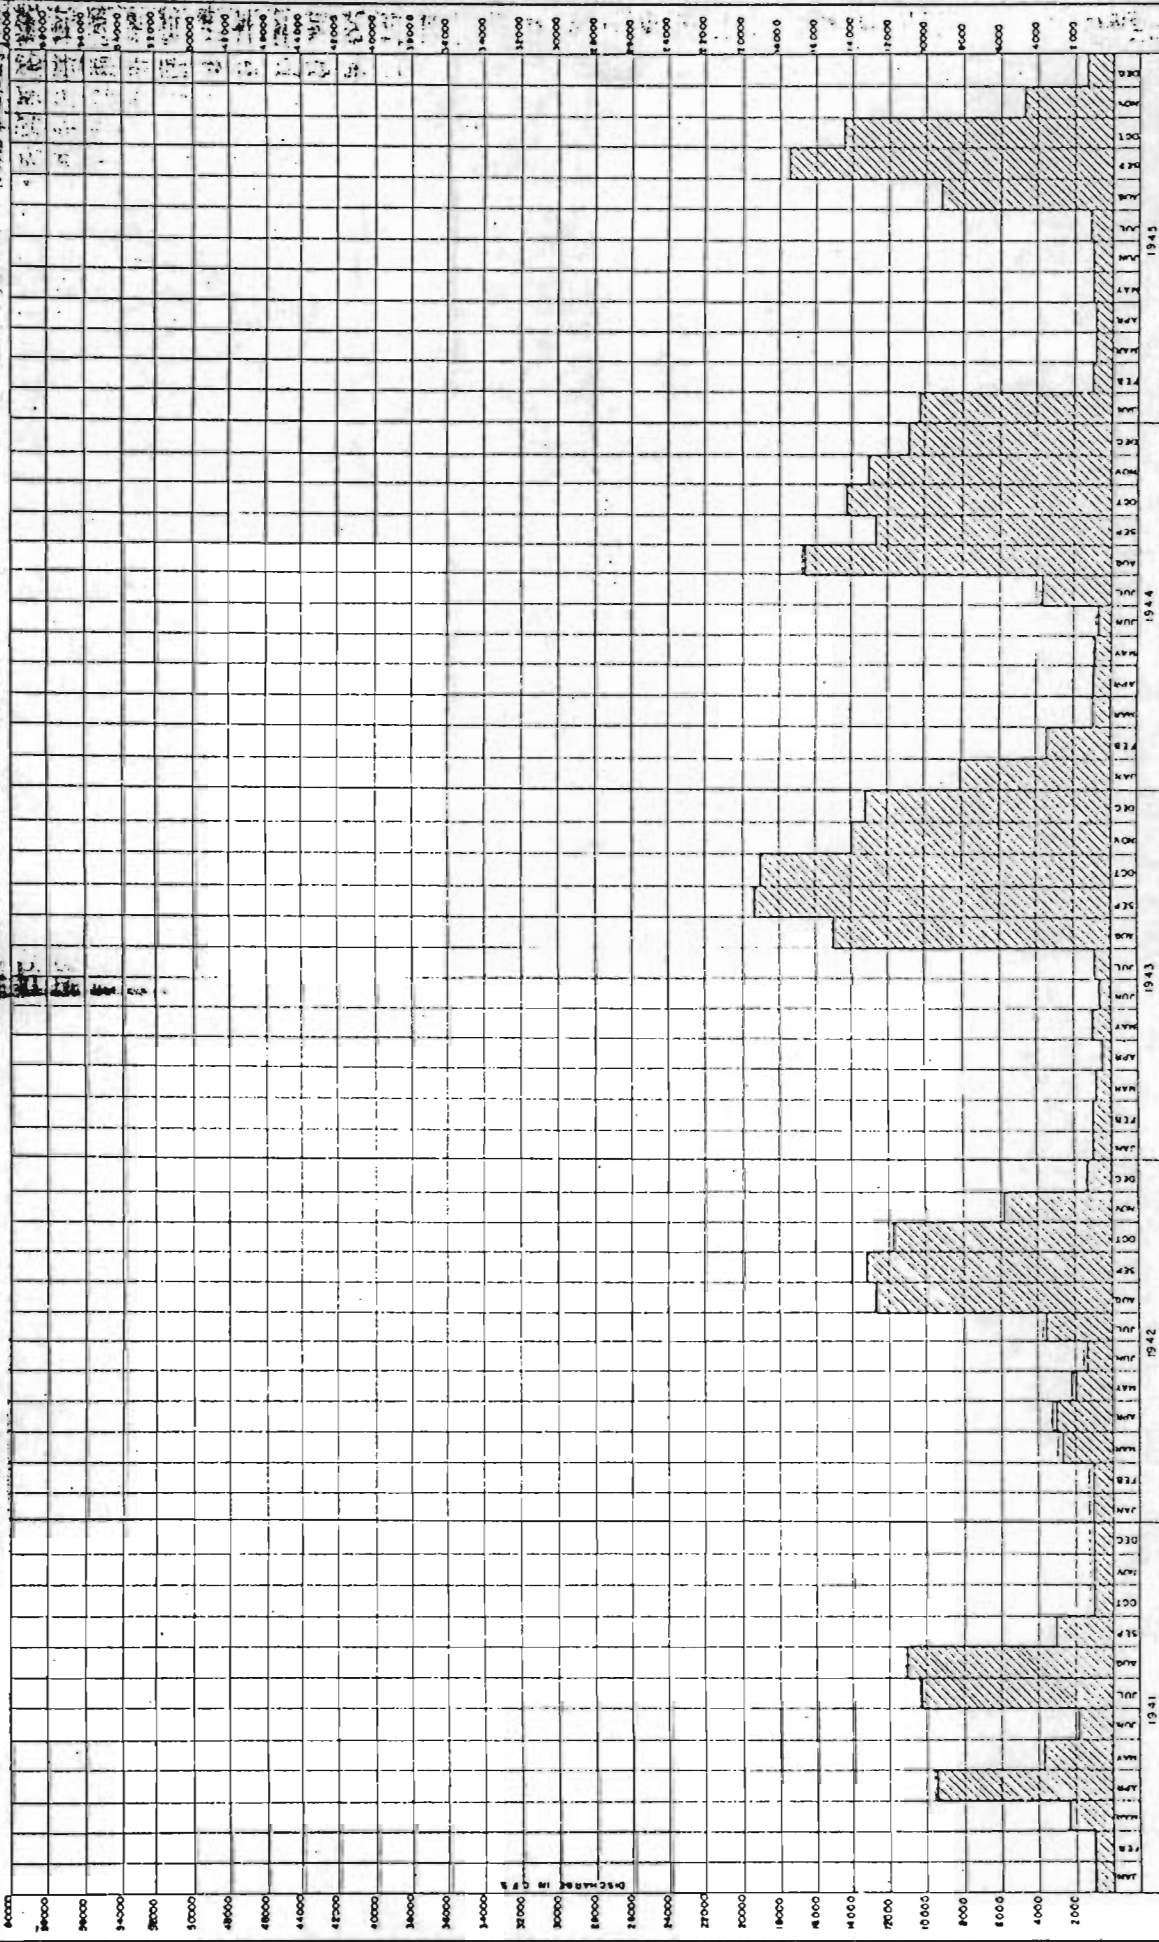

MISSOURI RIVER IMPROVEMENT
FORT PECK DAM
MEAN MONTHLY DISCHARGE

NO SHEETS SHEET NO. 2

FORT PECK DISTRICT, FORT PECK, MONTANA


DATE: JUL 1945

BY: [Signature]

7250 4-2-14

TUNNEL DISCHARGE

DATE	DISCHARGE
JAN	
FEB	
MAR	
APR	
MAY	
JUN	
JUL	
AUG	
SEP	
OCT	
NOV	
DEC	

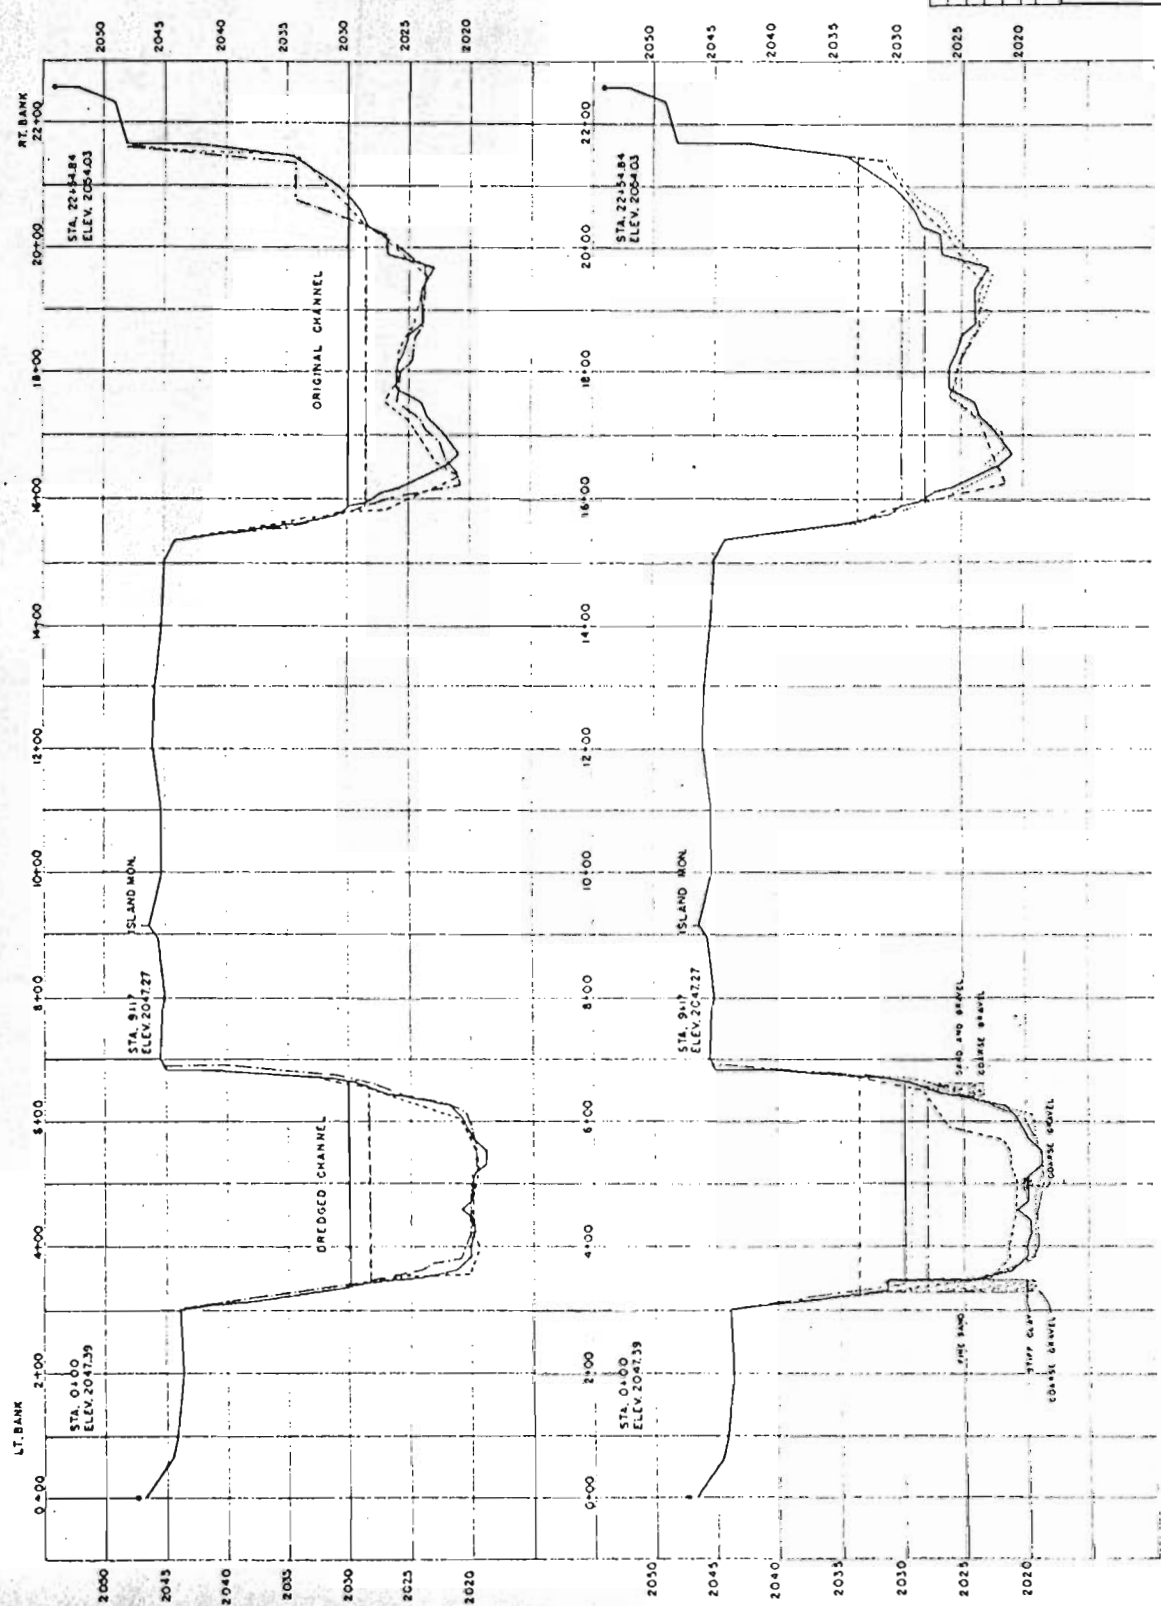


LEGEND
 W.S. ELEV. 2028.5 5-20-48
 R.B. ELEV. 2028.5 5-20-48
 W.S. ELEV. 2028.4 7-20-48
 R.B. ELEV. 2028.4 7-20-48
 W.S. ELEV. 2028.5 3-30-49
 R.B. ELEV. 2028.5 3-30-49



LEGEND
 W.S. ELEV. 2028.5 5-20-48
 R.B. ELEV. 2028.5 5-20-48

3	Sept 1950 Survey Added	11-10-50
4	April 1950 Survey Added	4-12-50
5	Sept 1950 Survey Added	7-10-50
6	3-30-49 Survey Added	4-15-49
SECTION TITLE: FORT PECK DAM
 DEGRADATION STUDIES
 RANGE ONE
 SHEET NO. 1
 PROJECT NO. 1
 DRAWN BY: 1
 CHECKED BY: 1
 DATE: 1950

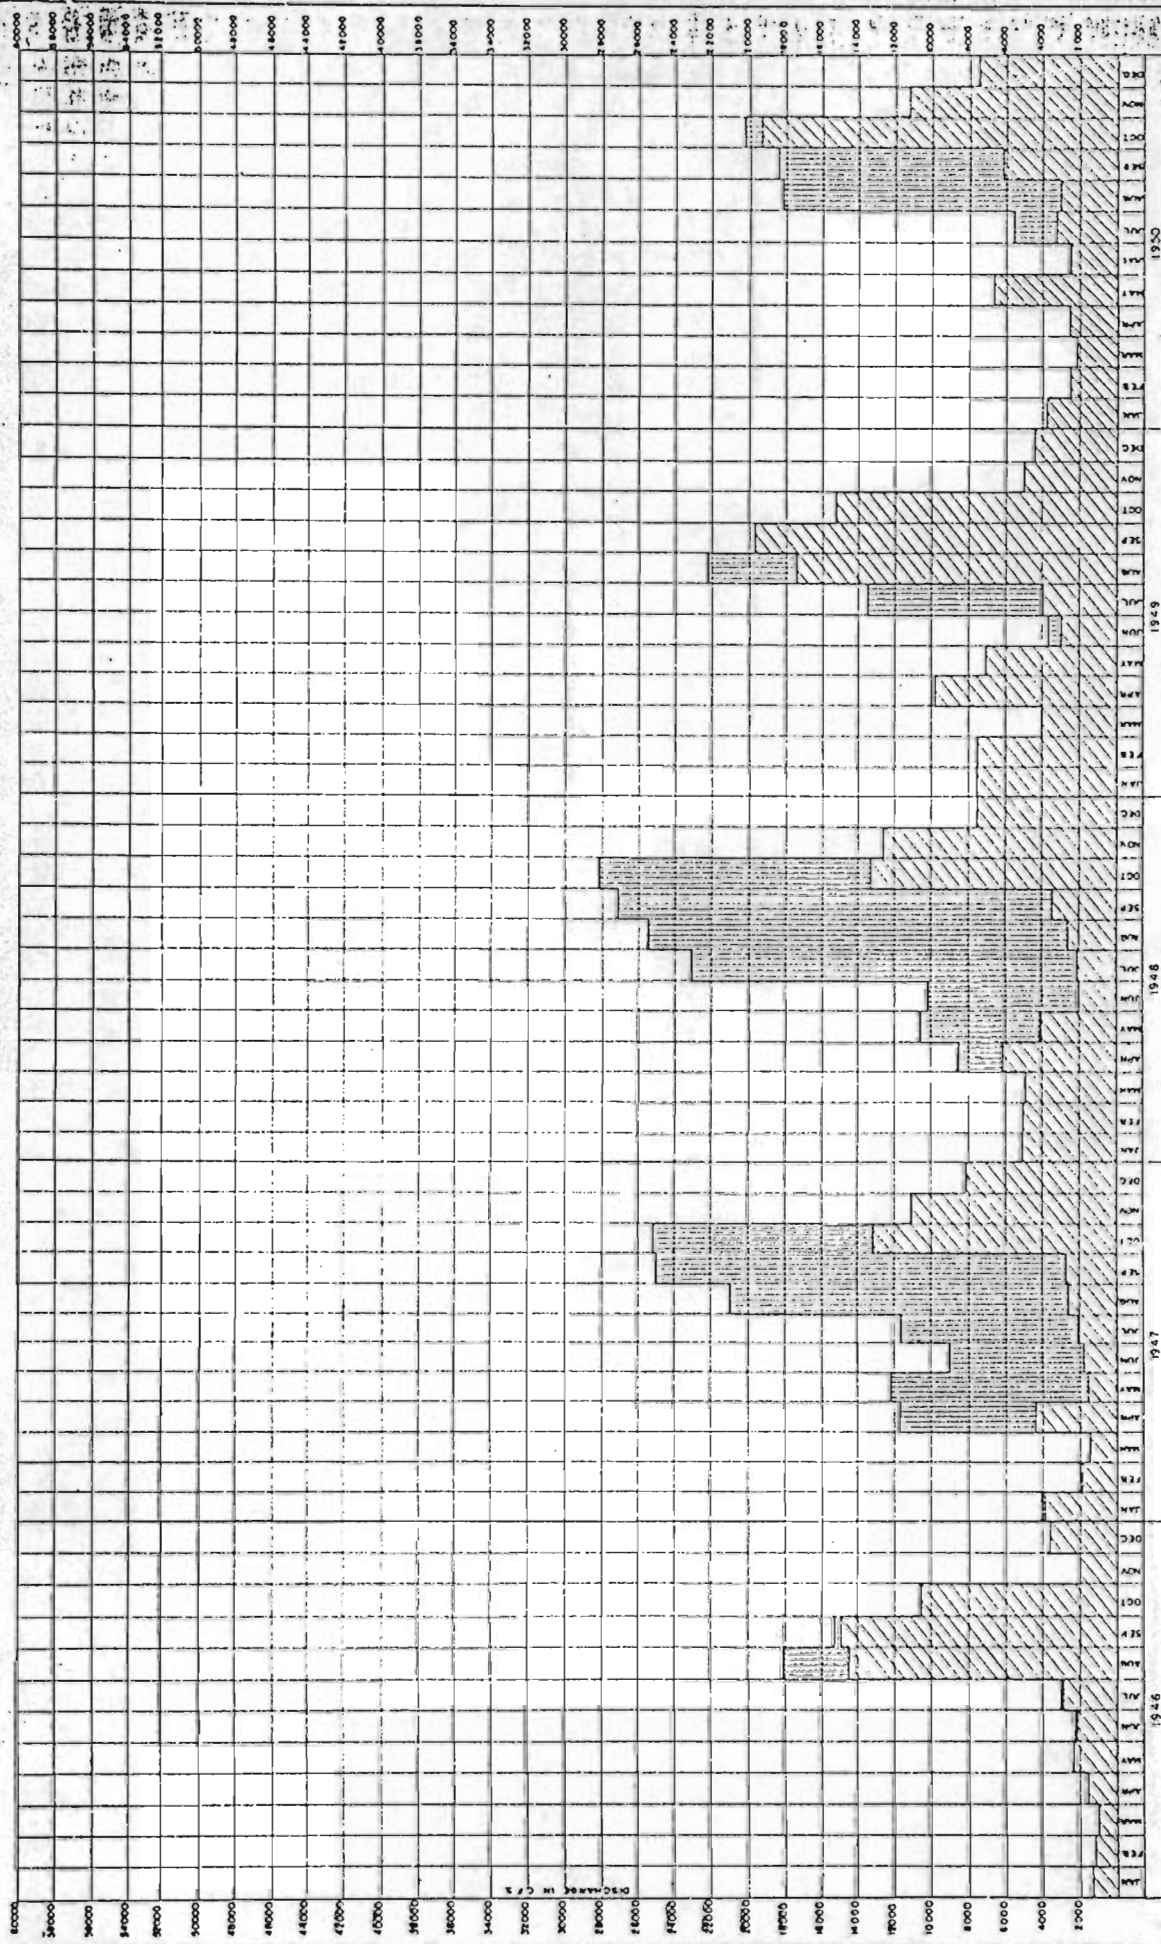NOTE: SECTION ADDED AUG 18, 1950




 ACTUAL DISCHARGE
 NORMAL DISCHARGE

FORT PECK DAM MEAN MONTHLY DISCHARGE

SHEET NO. 1
 FORT PECK DAM, MONTANA
 7250 4-2-18

DATE	REVISIONS

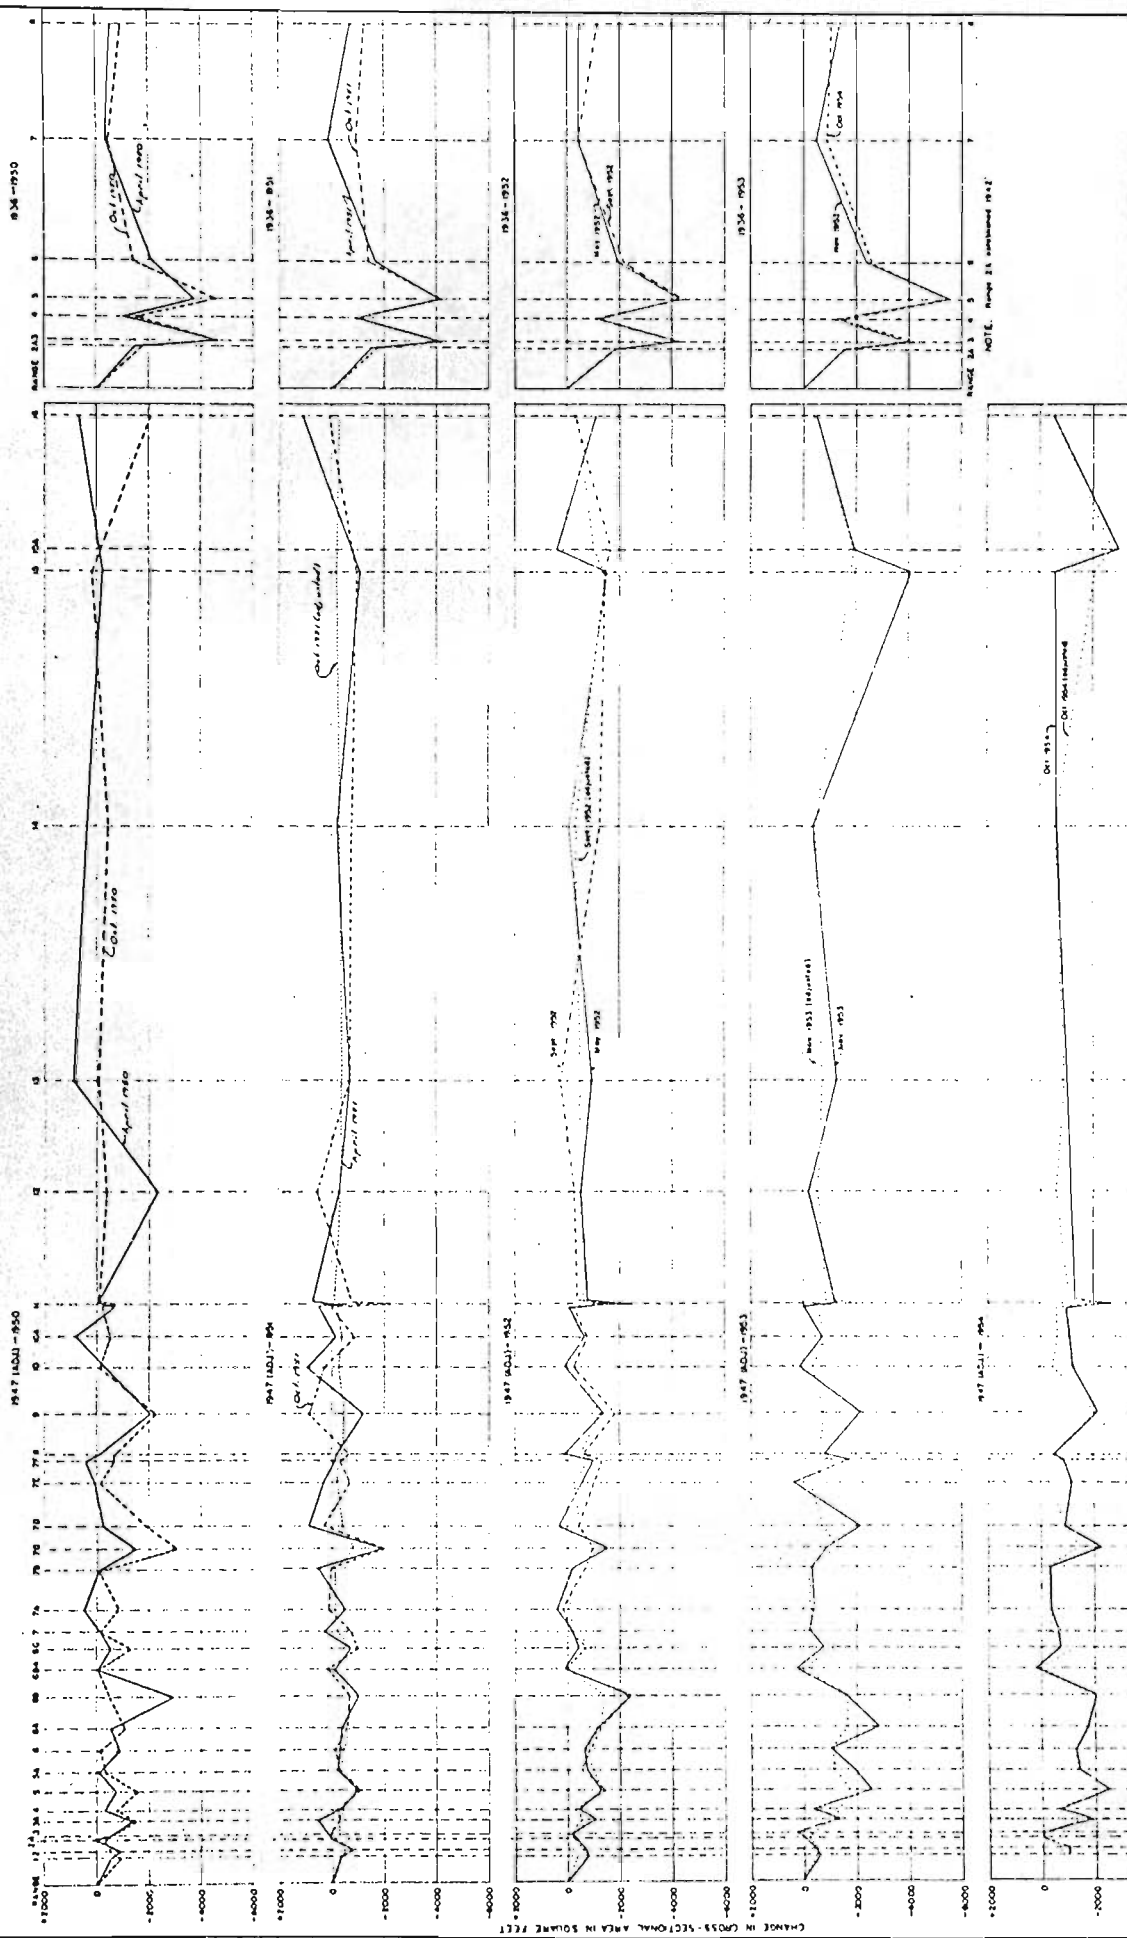

MISSOURI RIVER COMMISSION
FORT PECK DAM
DEGRADATION STUDIES
CUMULATIVE CHANGES
IN CROSS-SECTIONAL AREA

SHEET NO. 2










DATE: 1957

BY: [Signature]

FOR: [Signature]

7250 4-2-231

NO.	REVISIONS	DATE	BY
1	1	10/15/57	J.M.



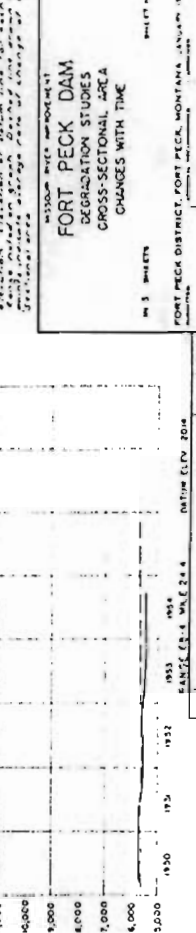
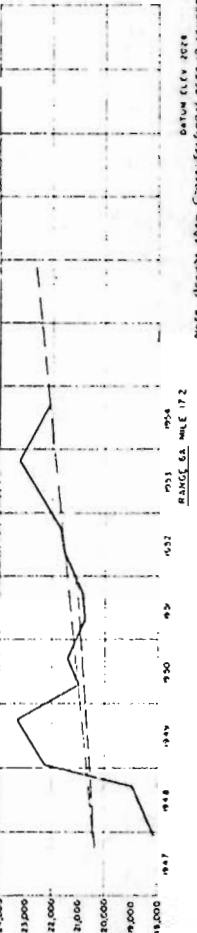
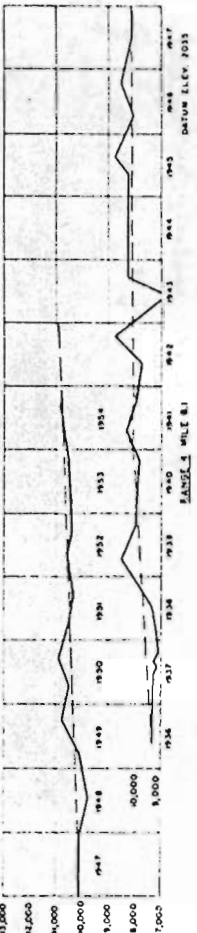
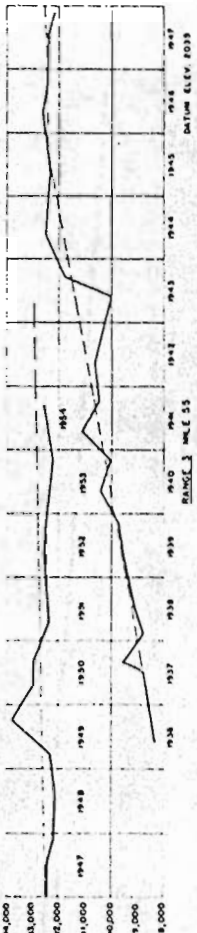
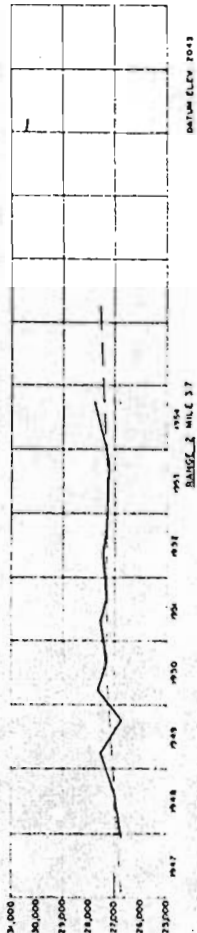
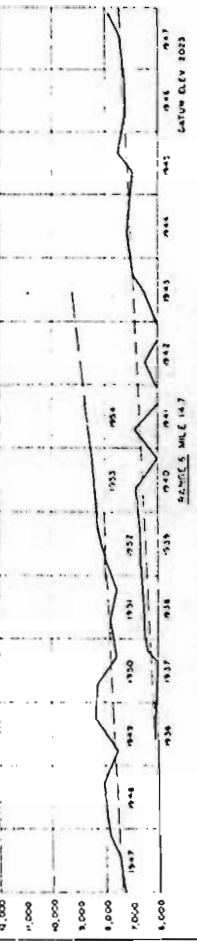
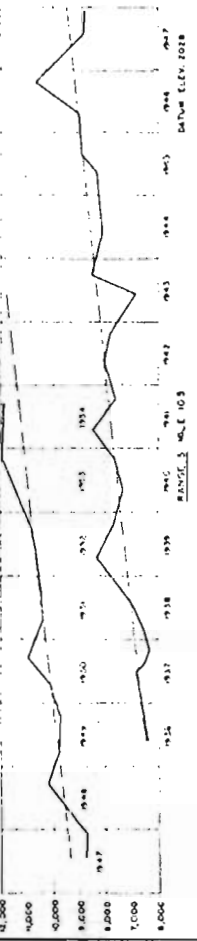
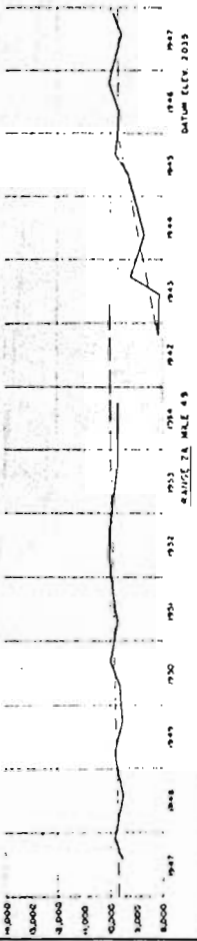
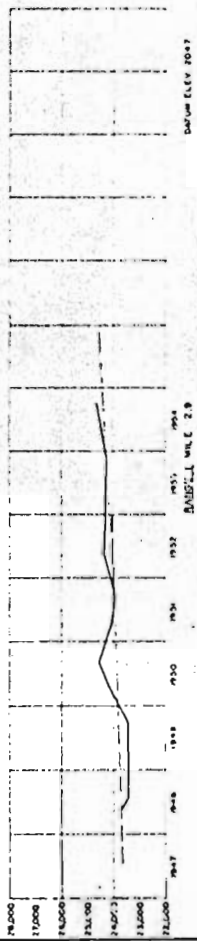



FORT PECK DAM DEGRADATION STUDIES CROSS-SECTIONAL AREA CHANGES WITH TIME

FORT PECK DISTRICT, FORT PECK, MONTANA, JANUARY 1952
PROJECT NO. 1
SHEET NO. 1
7250 4-2-232


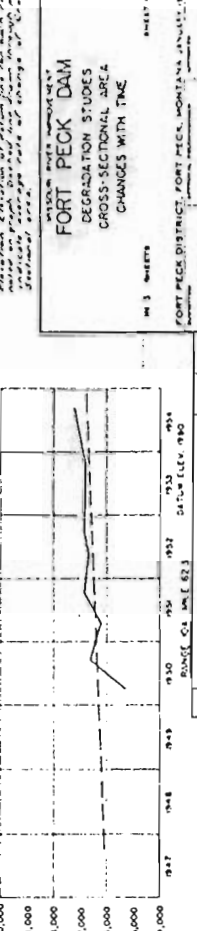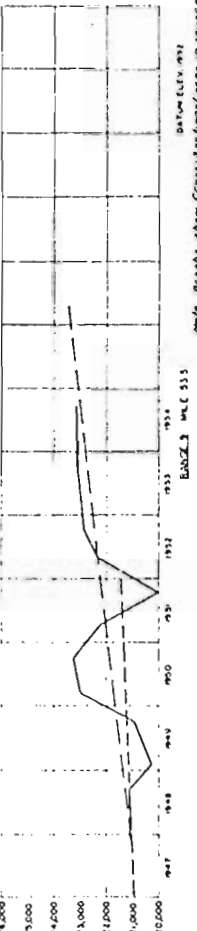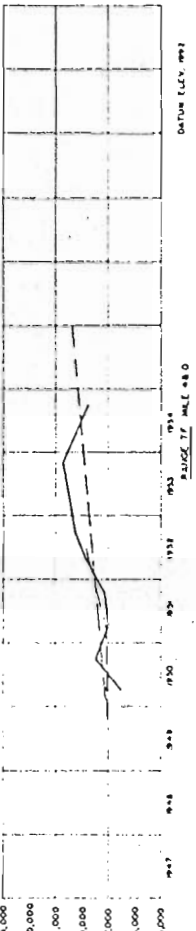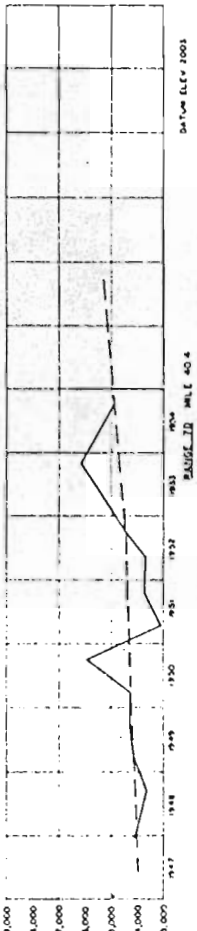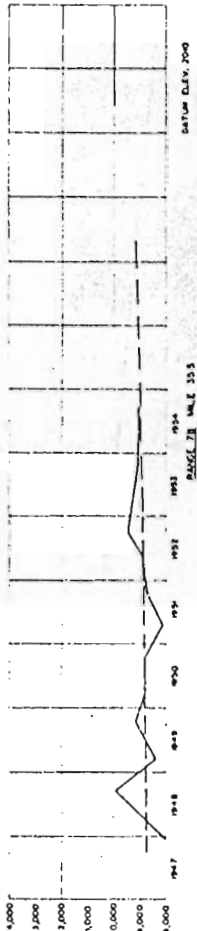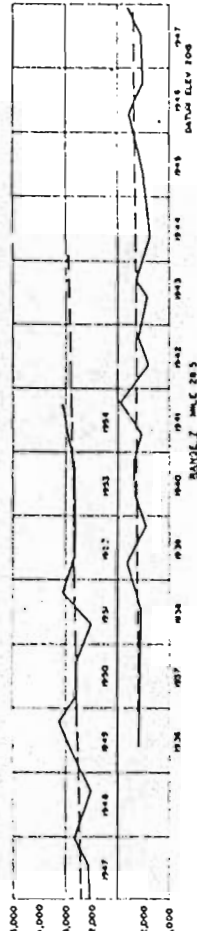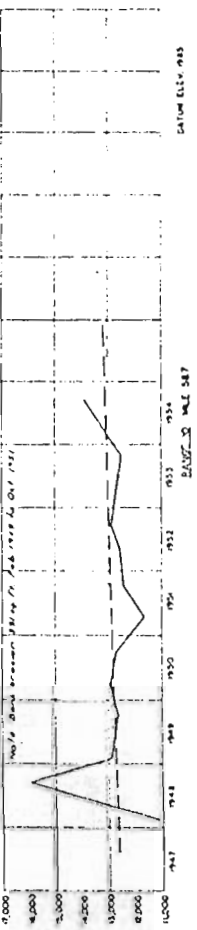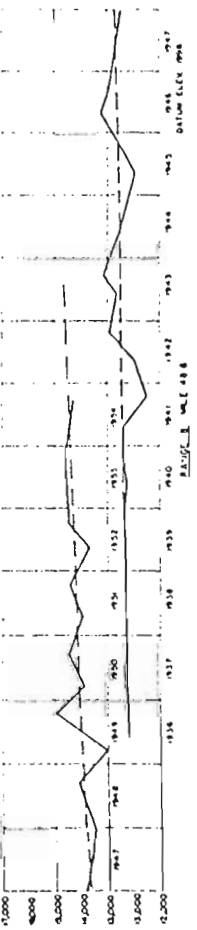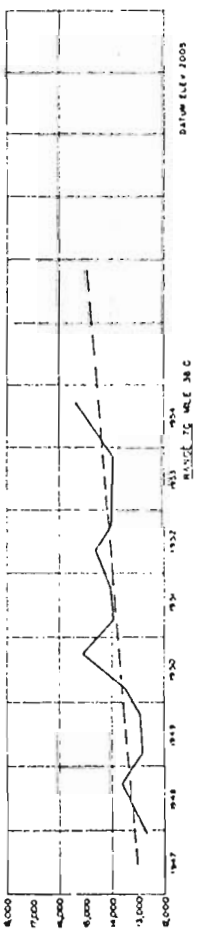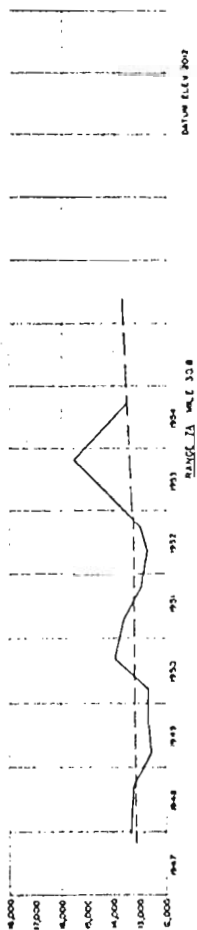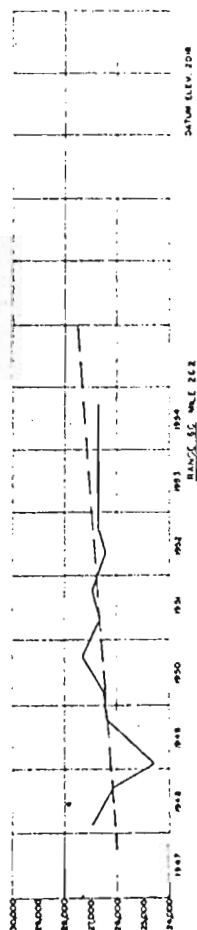

NOTE: Elevation shown on this map is based on the original profile of the area. The profile shown on this map is the result of a survey made in 1954. 

FORT PECK DAM
DEGRADATION STUDIES
CROSS-SECTIONAL AREA
CHANGES WITH TIME

NO. 3 SHEETS

FORT PECK DISTRICT, FORT PECK, MONTANA, JANUARY 1952

REVISIONS

7250.4-2-233



**FORT PECK DAM:
DEGRADATION STUDIES
CROSS-SECTIONAL AREA
CHANGES WITH TIME**


10-11-1994

—

[illegible]

729.72-3-394

[illegible]

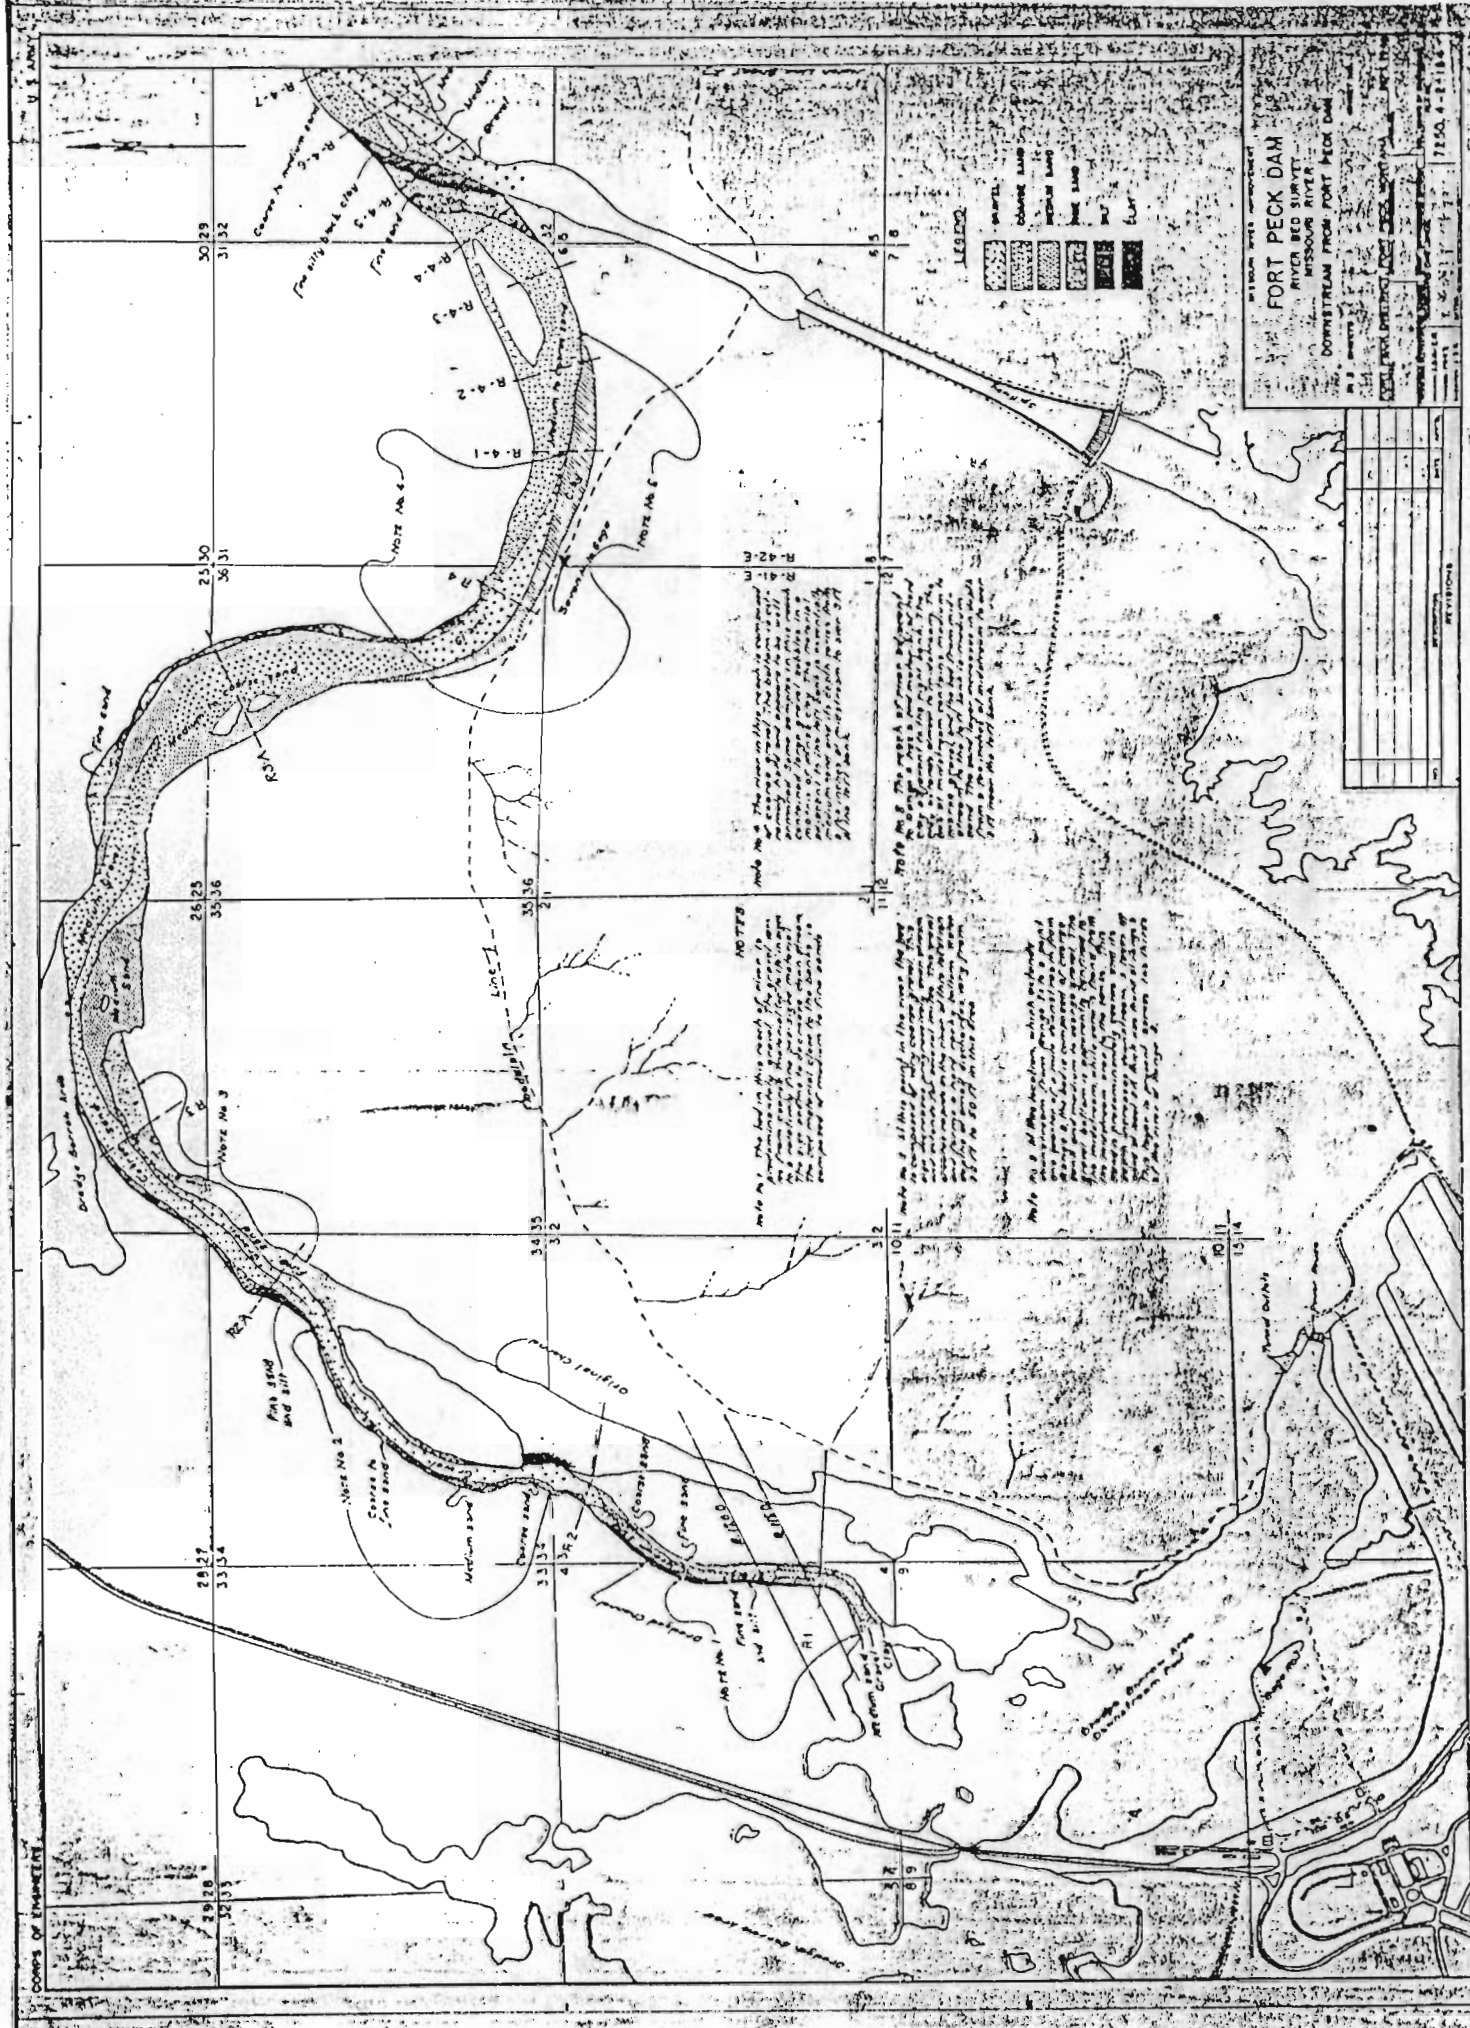

MISSOURI RIVER PROJECT
FORT PECK DAM
RIVER BED SURVEY
MISSOURI RIVER

REVISIONS	

LEGEND





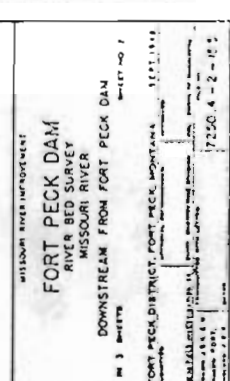



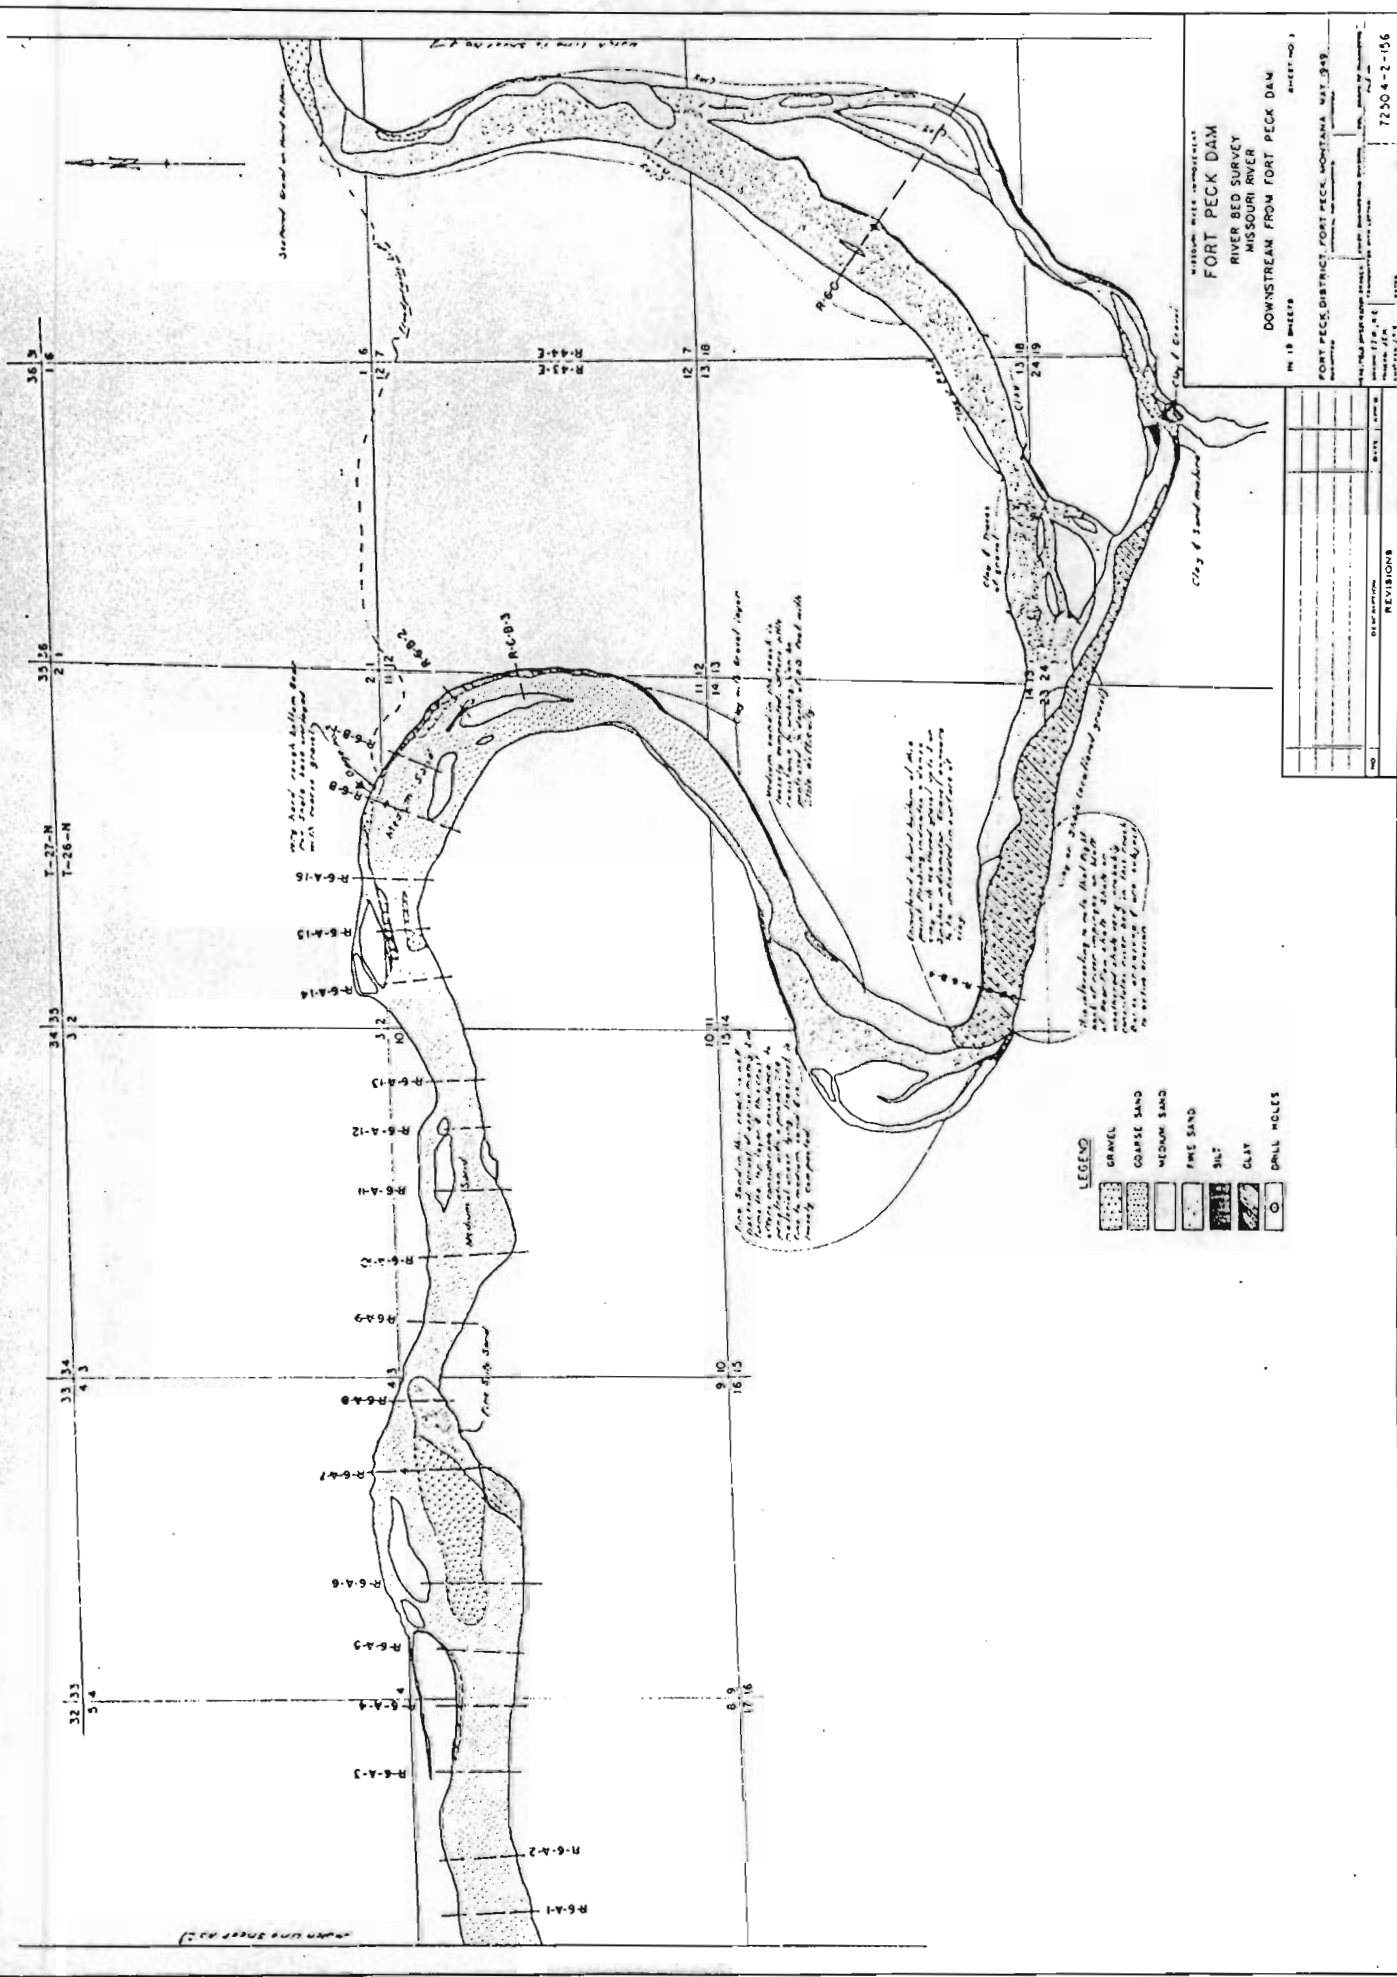

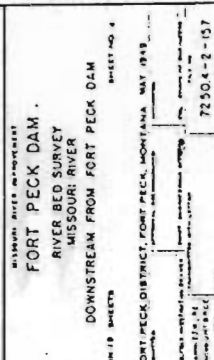

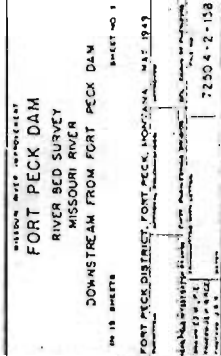

REVISIONS			Date	By
1				
2				
3				
4				
5				

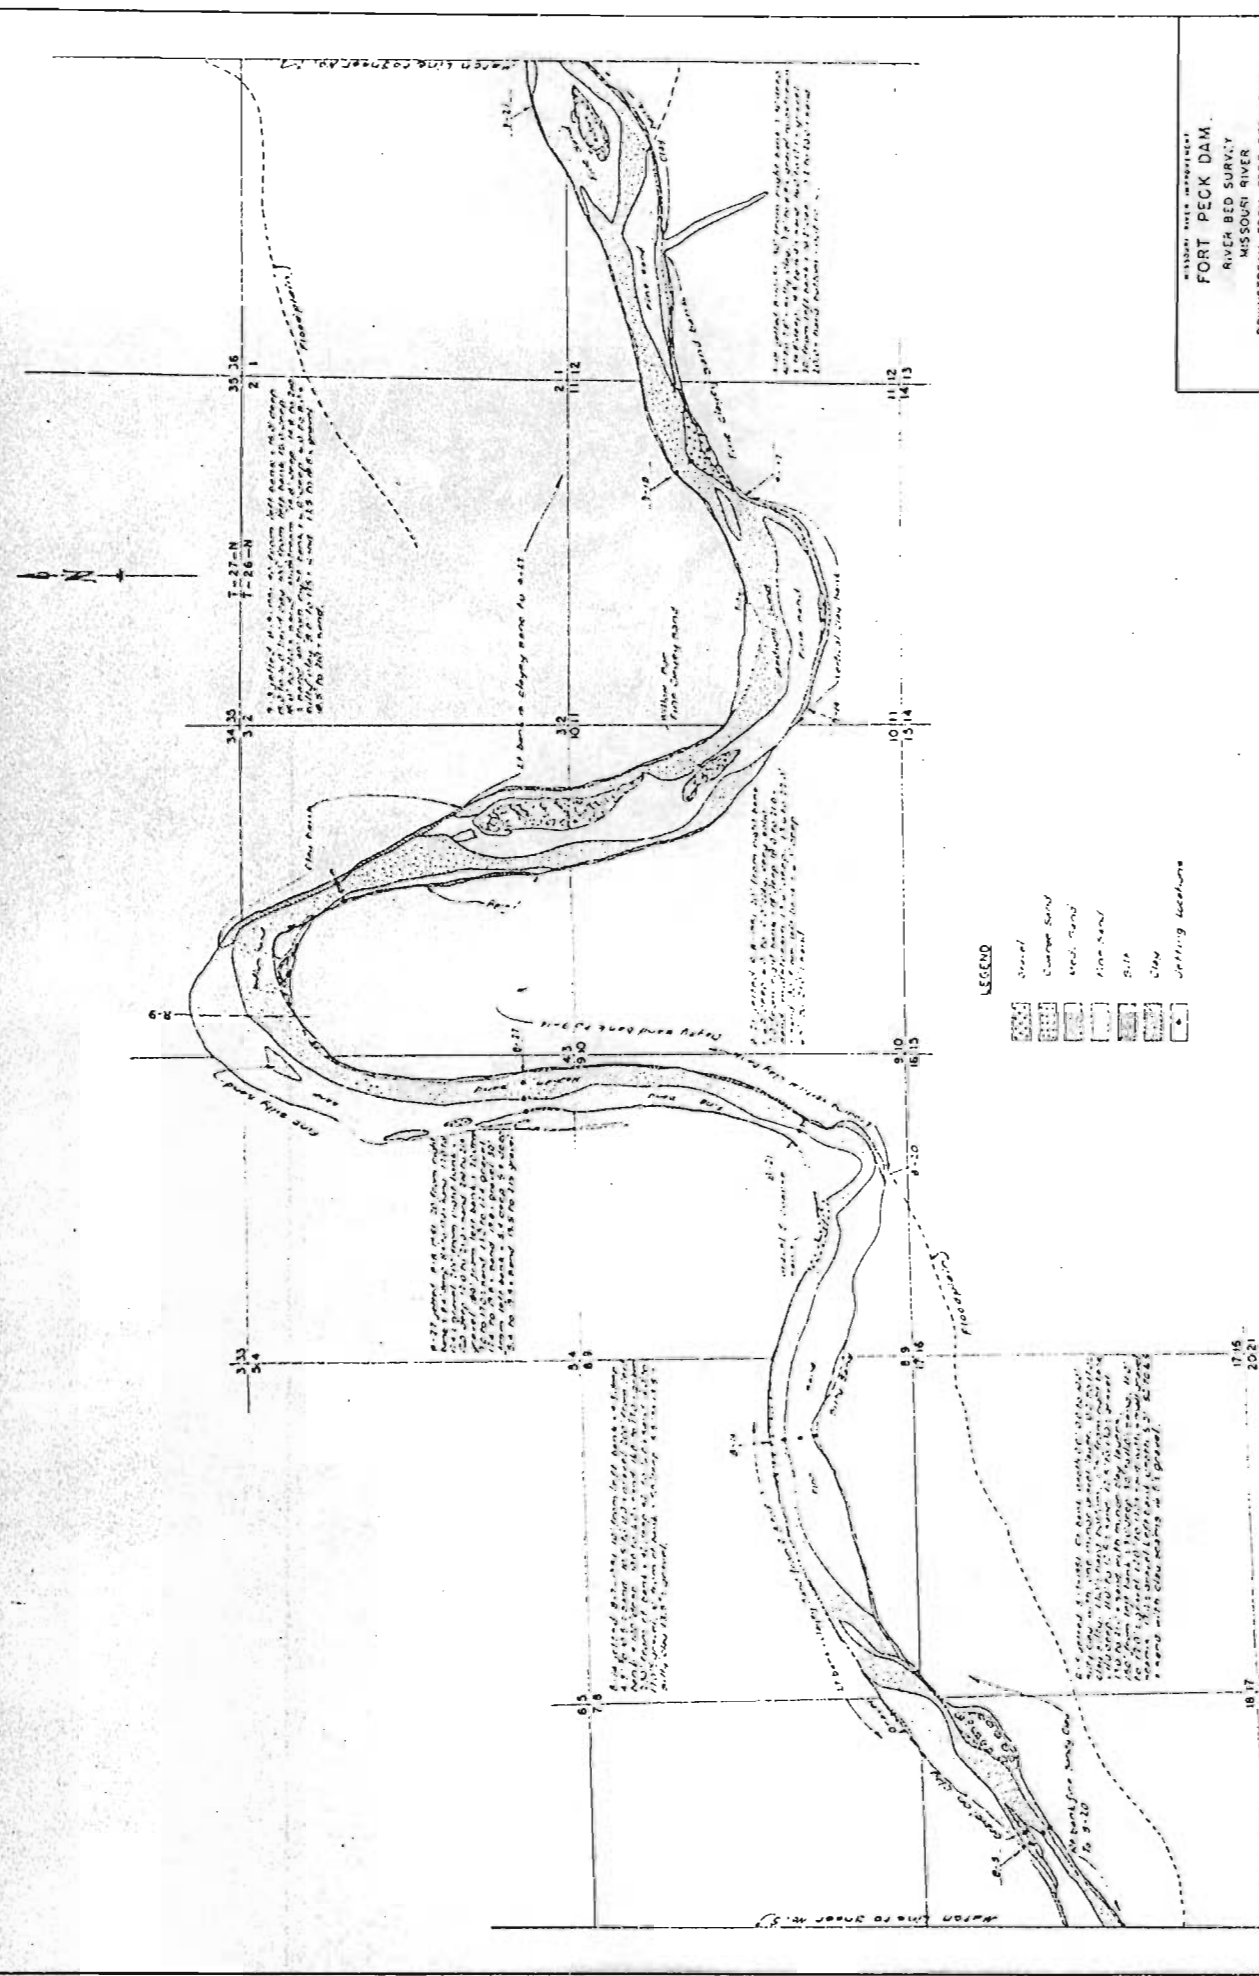


NO.	DATE	REVISIONS
1		
2		
MISSION: RIVER IMPROVEMENT
FORT PECK DAM
RIVER BED SURVEY
MISSOURI RIVER
DOWNSTREAM FROM FORT PECK DAM
SHEET NO. 1
NO. 18 SHEETS
7250-4-2-1-23



DOWNSTREAM FROM FORT PECK DAM

PORT PECK DISTRICT, FORT PECK, MONTANA, MAY 1949

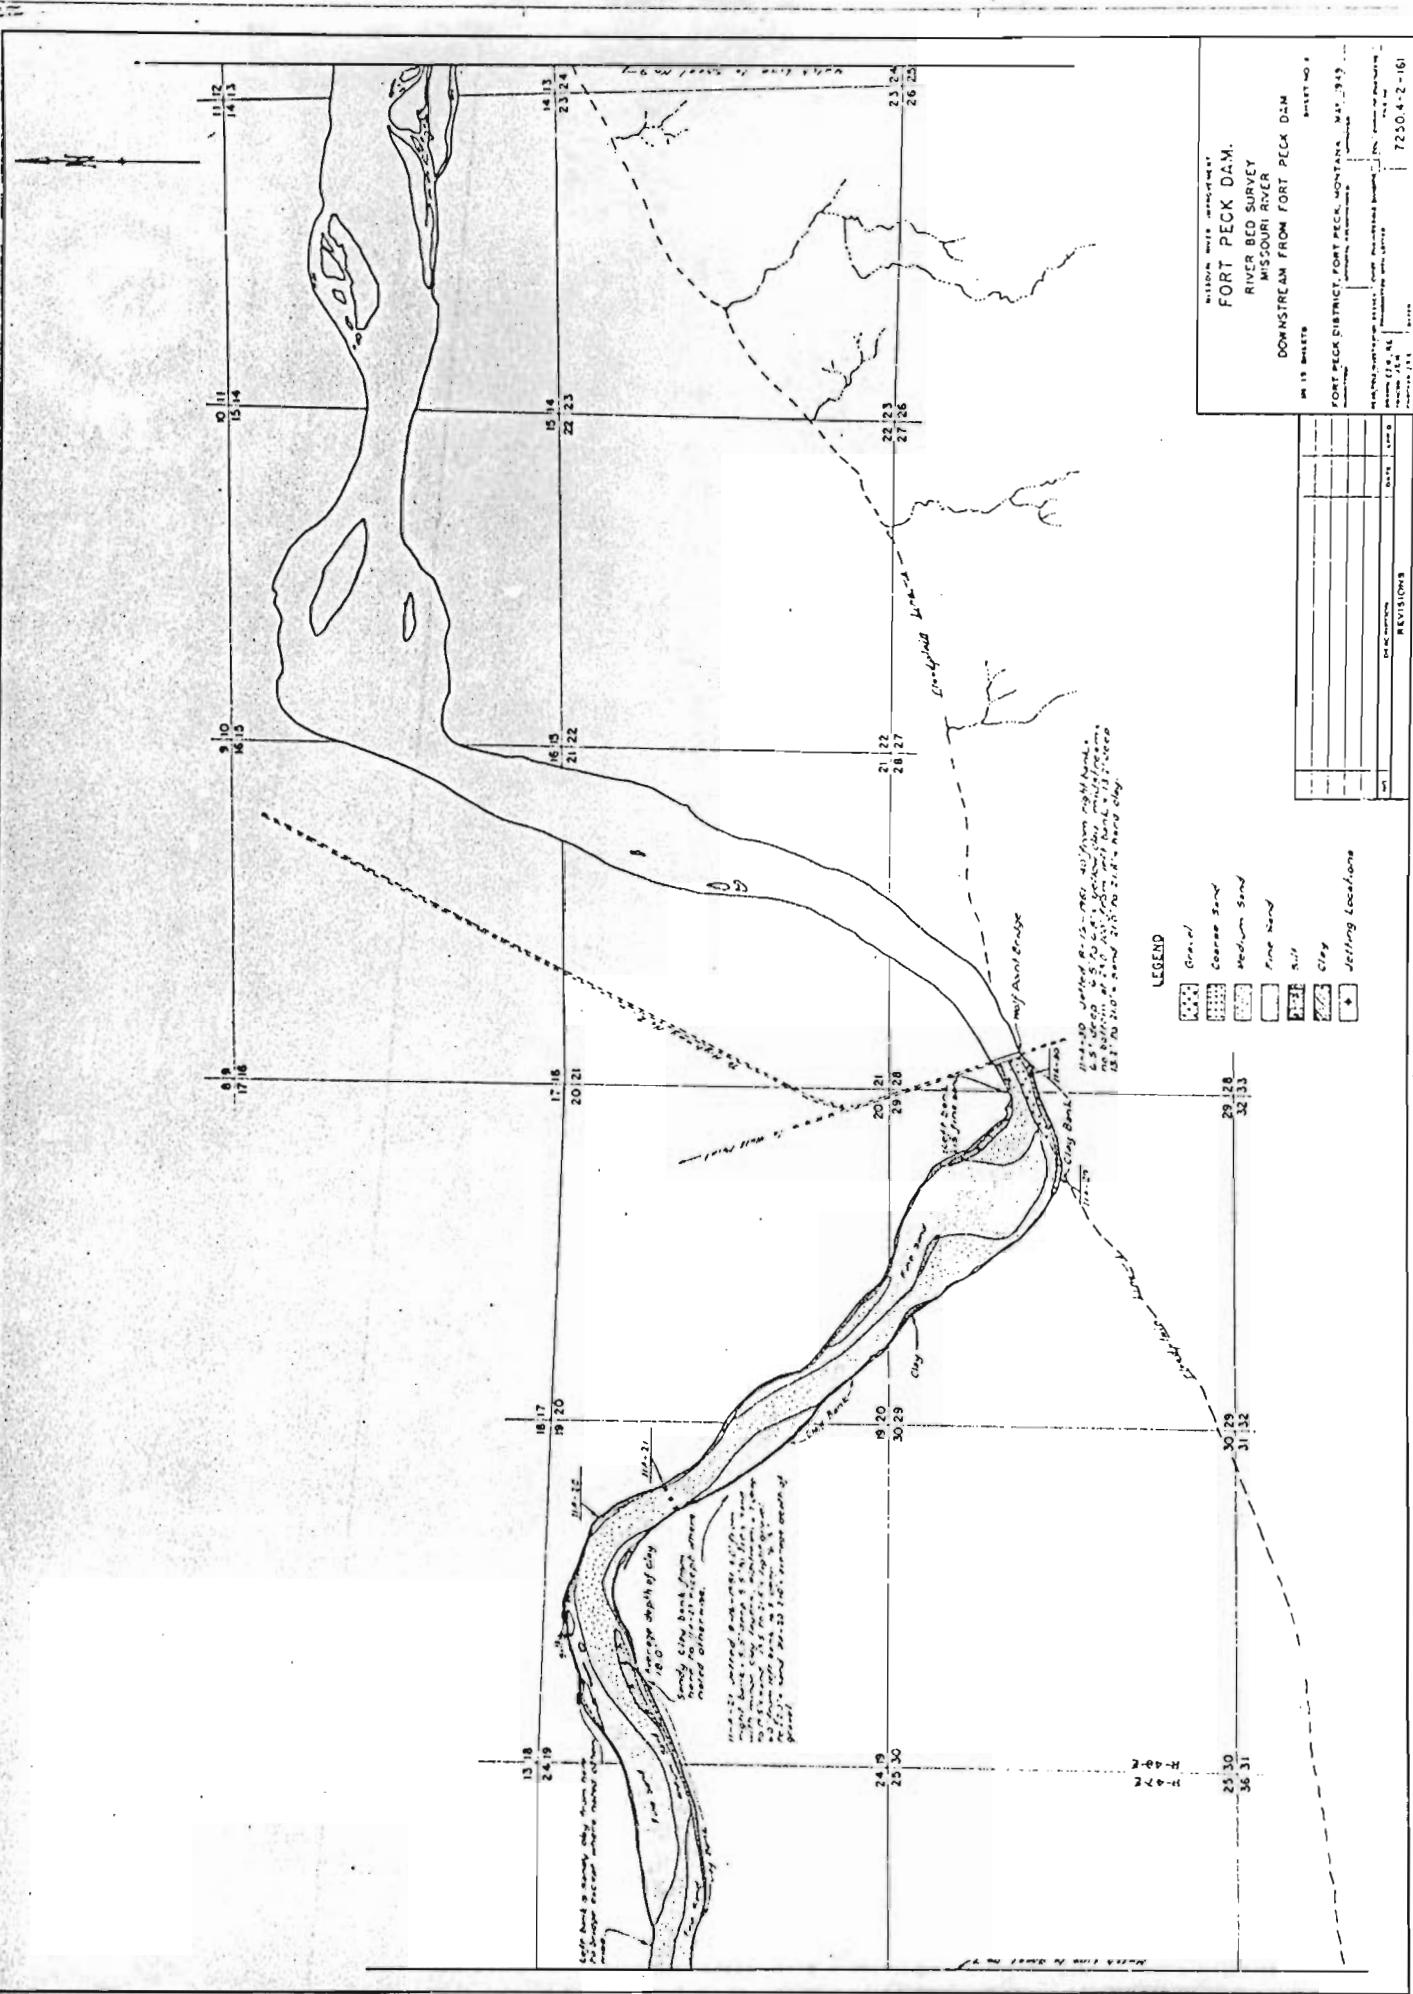

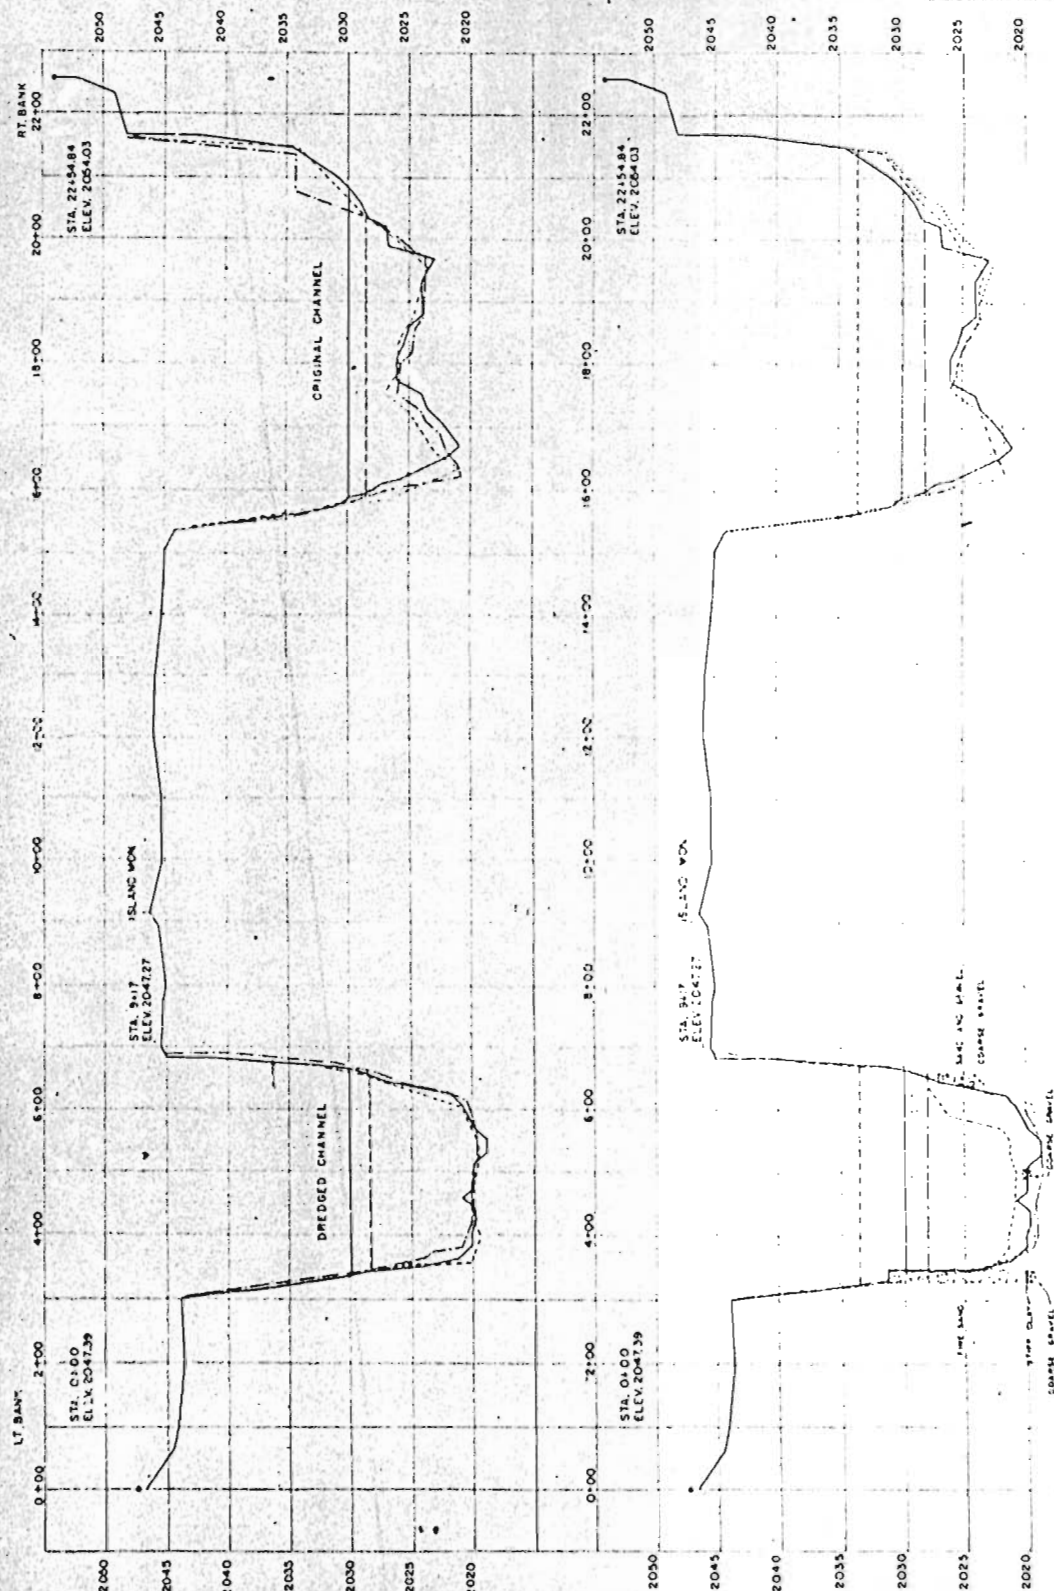




FORT PECK DAM
DEGRADATION STUDIES

IN SHEETS
RANGE ONE
FORT PECK DISTRICT FOR PECK MONTANA
SHEET NO. 72504-2-140

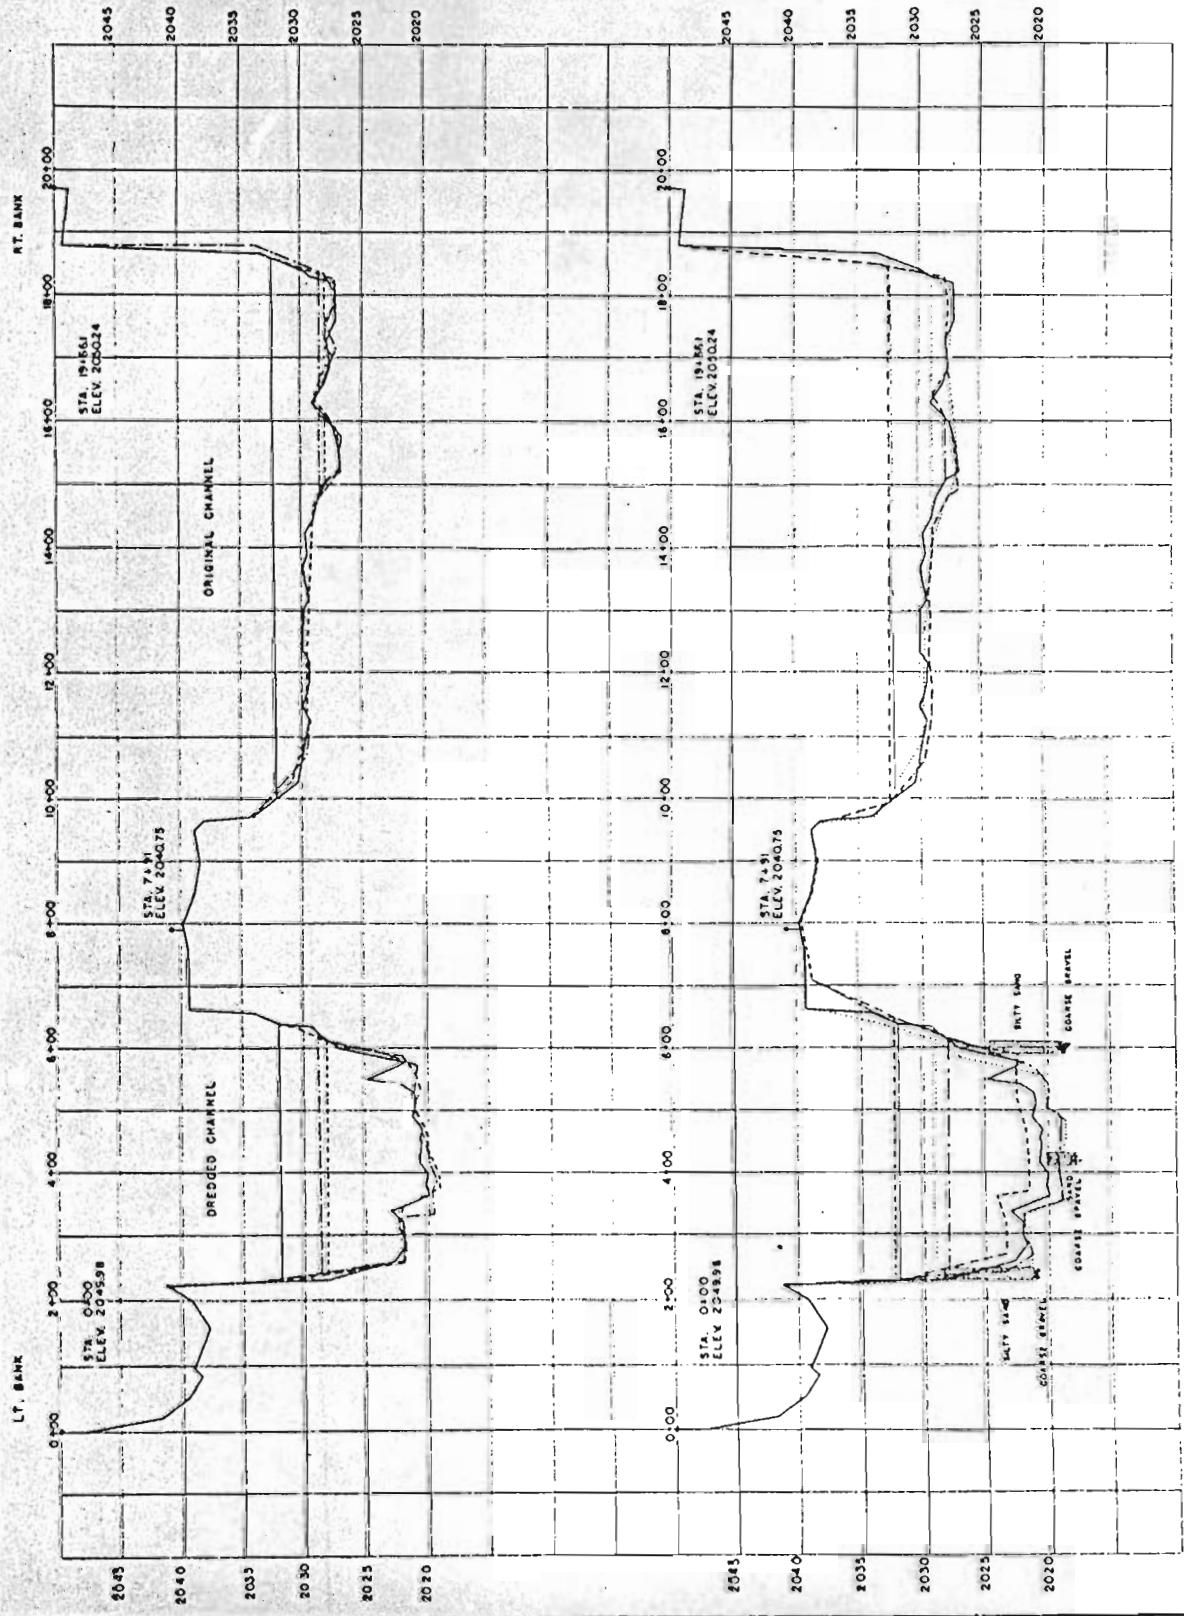

LEGEND



3	SEPT. 1950 SURVEY ADDED	11-30-50
4	APRIL 1950 SURVEY ADDED	1-17-51
5	SEP. 1949 SURVEY ADDED	1-20-51
6	3-30-49 SURVEY ADDED	1-23-51
7	SHORT REVISION	1-27-51
8	REVISION	3-17-51
9	REVISION	3-17-51

FORT PECK DAM
DEGRADATION STUDIES
RANGE TWO

NO. SHEETS
SHEET NO.

FORT PECK DISTRICT, FORT PECK, MONTANA


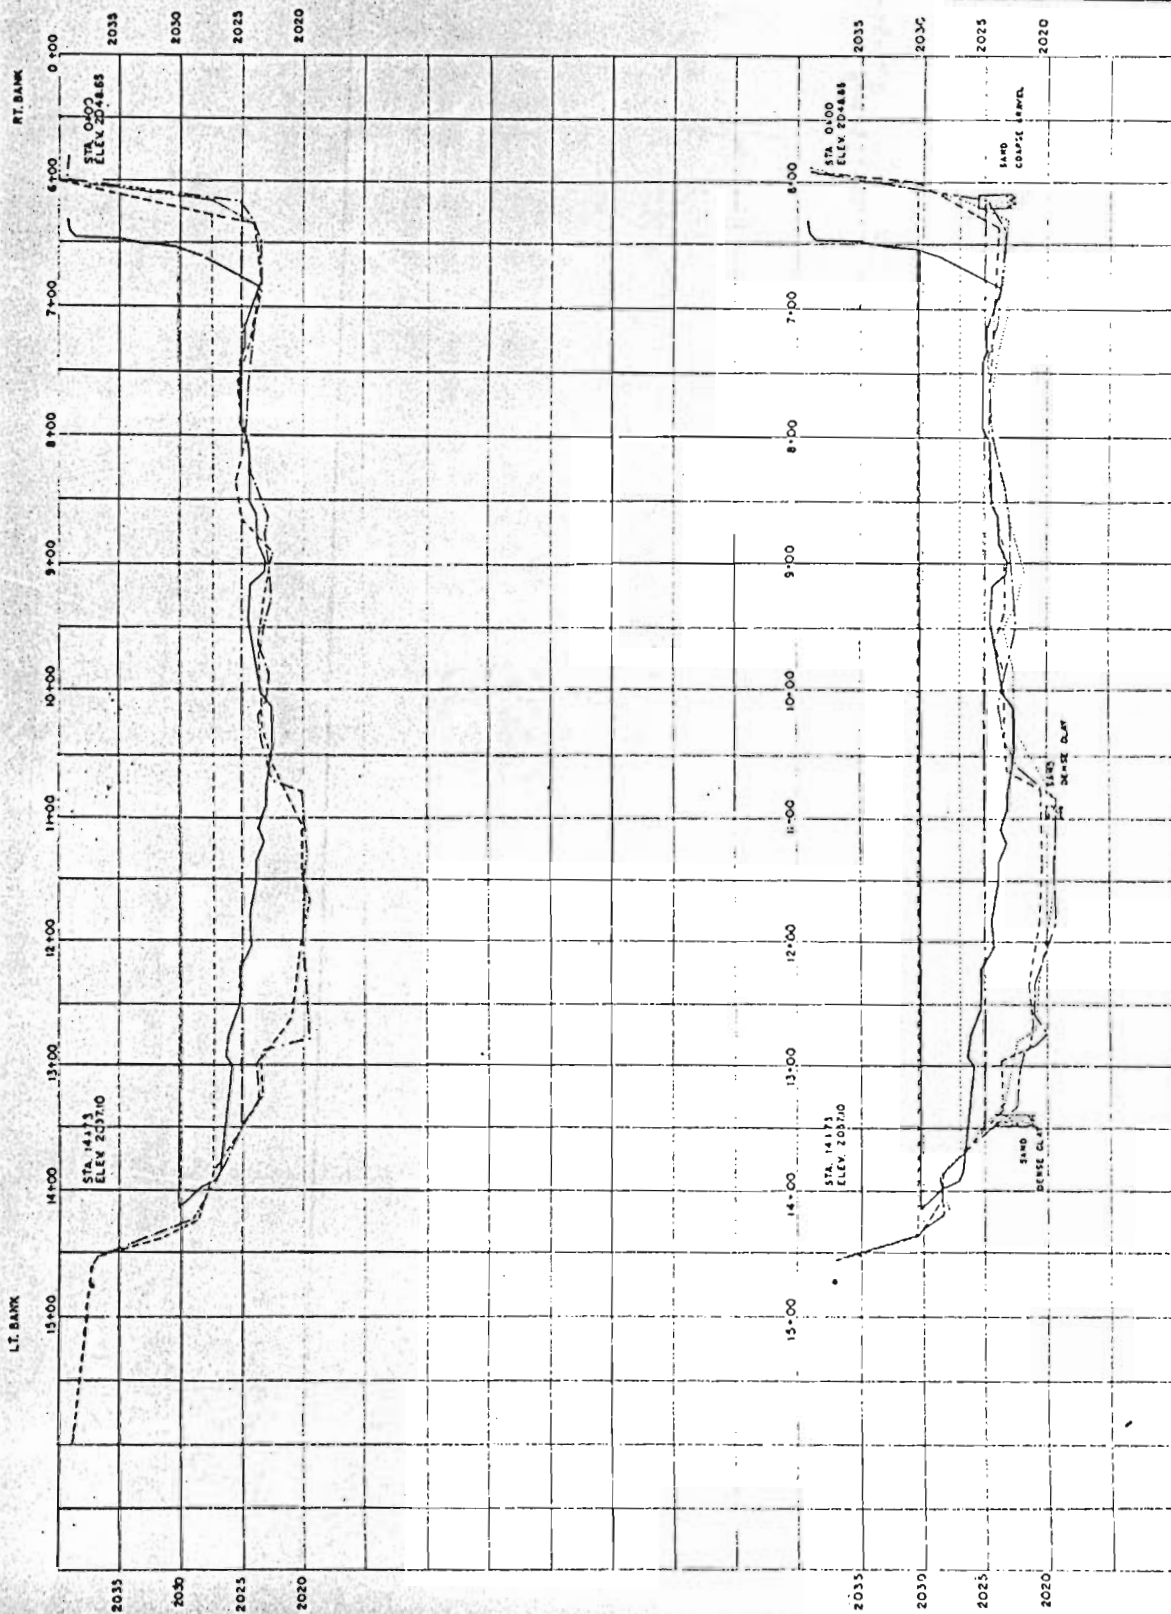

COPY: SEC-MR JUD. 16, 1950
ALONG INDICATES GRAVEL ON ITS TO RIGHT OF STA. 10+31

W.S. - WATER SURFACE
R.B. - RIVER BED

LEGEND

W.S. ELEV. 2002	10-21-42
R.B. ELEV.	10-21-42
W.S. ELEV. 2022	7-22-48
R.B. ELEV.	7-22-48
W.S. ELEV. 2021	3-23-49
R.B. ELEV.	3-23-49


[illegible]

NO	DESCRIPTION	DATE	REVISIONS
5	SEPT 1950 SURVEY ADDED	9-11-50	
4	April 1950 Survey added	4-17-50	
3	Sept 1950 Survey Added	9-20-50	
2	3-23-49 Survey Added	4-25-49	
1	Sheet Redrawn	4-25-49	

FORT PECK DAM
DEGRADATION STUDIES

RANGE TWO-A

100 SHEETS
 72504-2187

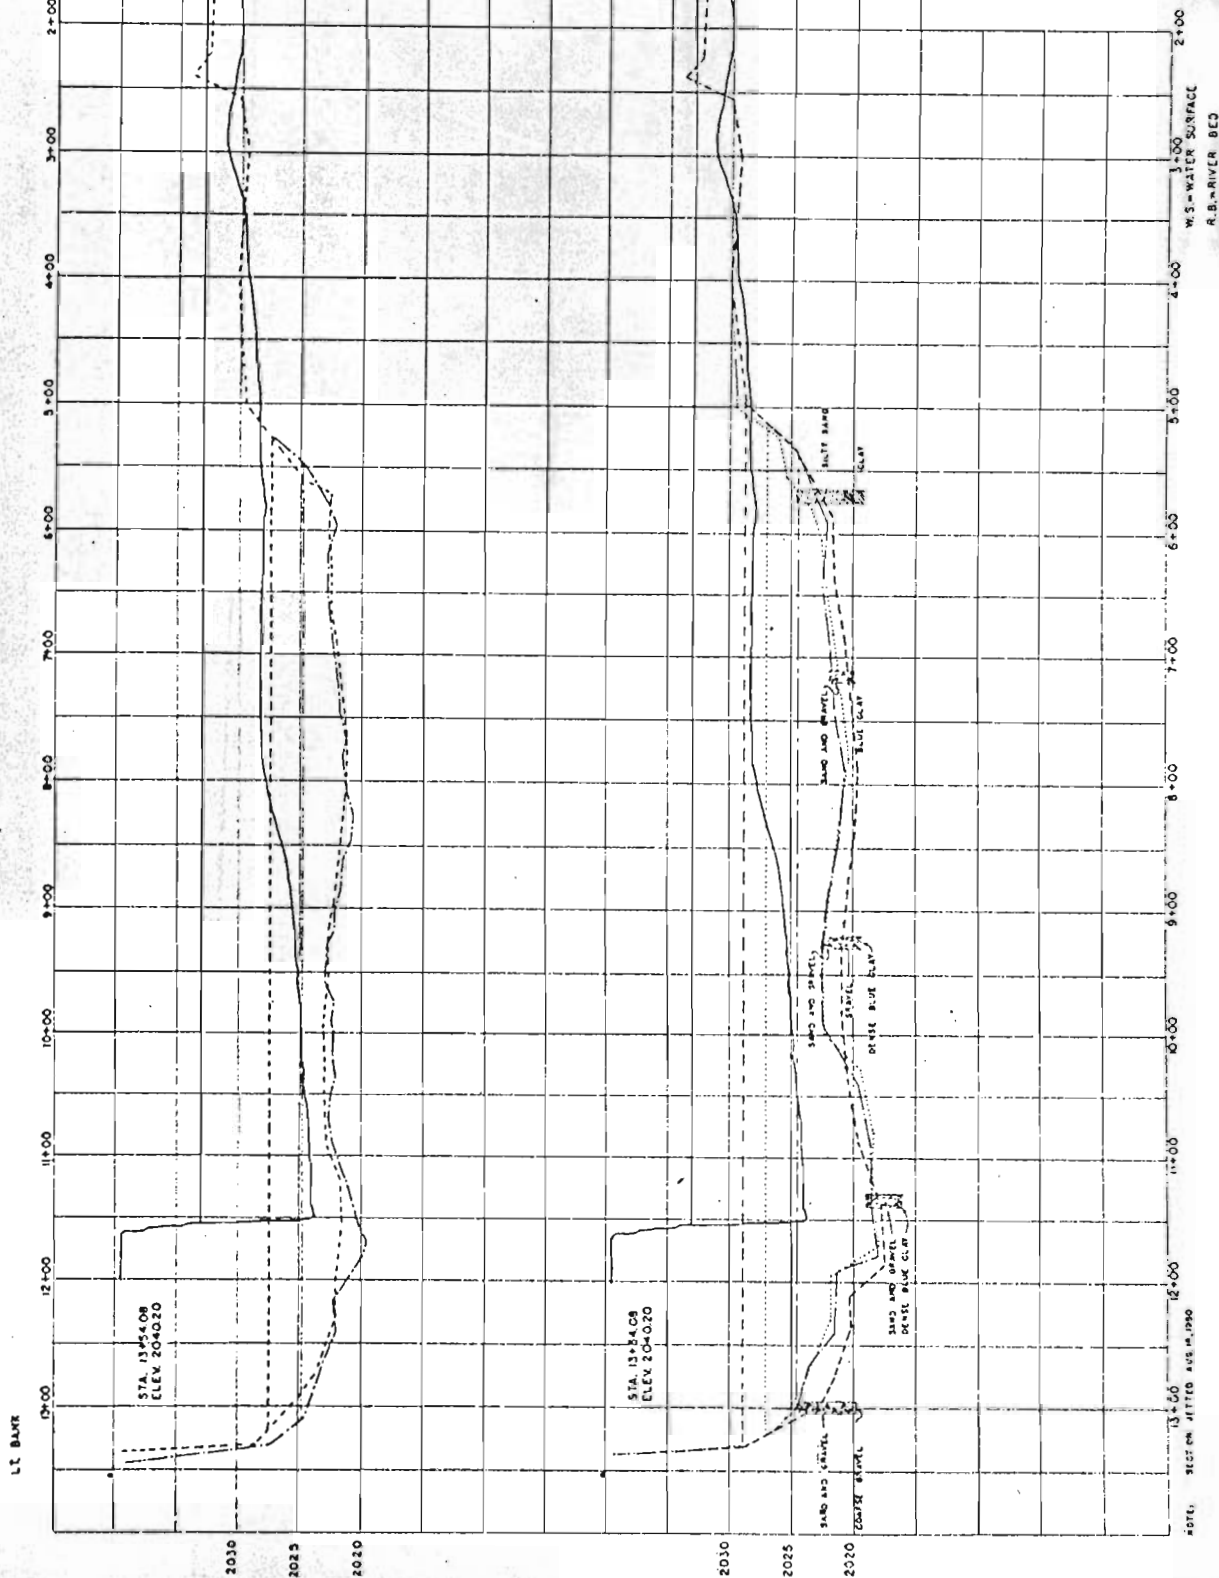


5	SEPT. 1950 SURVEY ADDED	12-150
4	1951/1950 Survey added	6-3055
3	SEPT. 49 Survey added.	1-70-50
2	3-23-49 Survey Added	1-23-49
1	Sheet Redrawn	1-23-49
50	Revised	


FORT PECK DAM

DEGRADATION STUDIES

RANGE THREE


M

FORTY PECK DISTRICT, FORT PECK, MONTANA




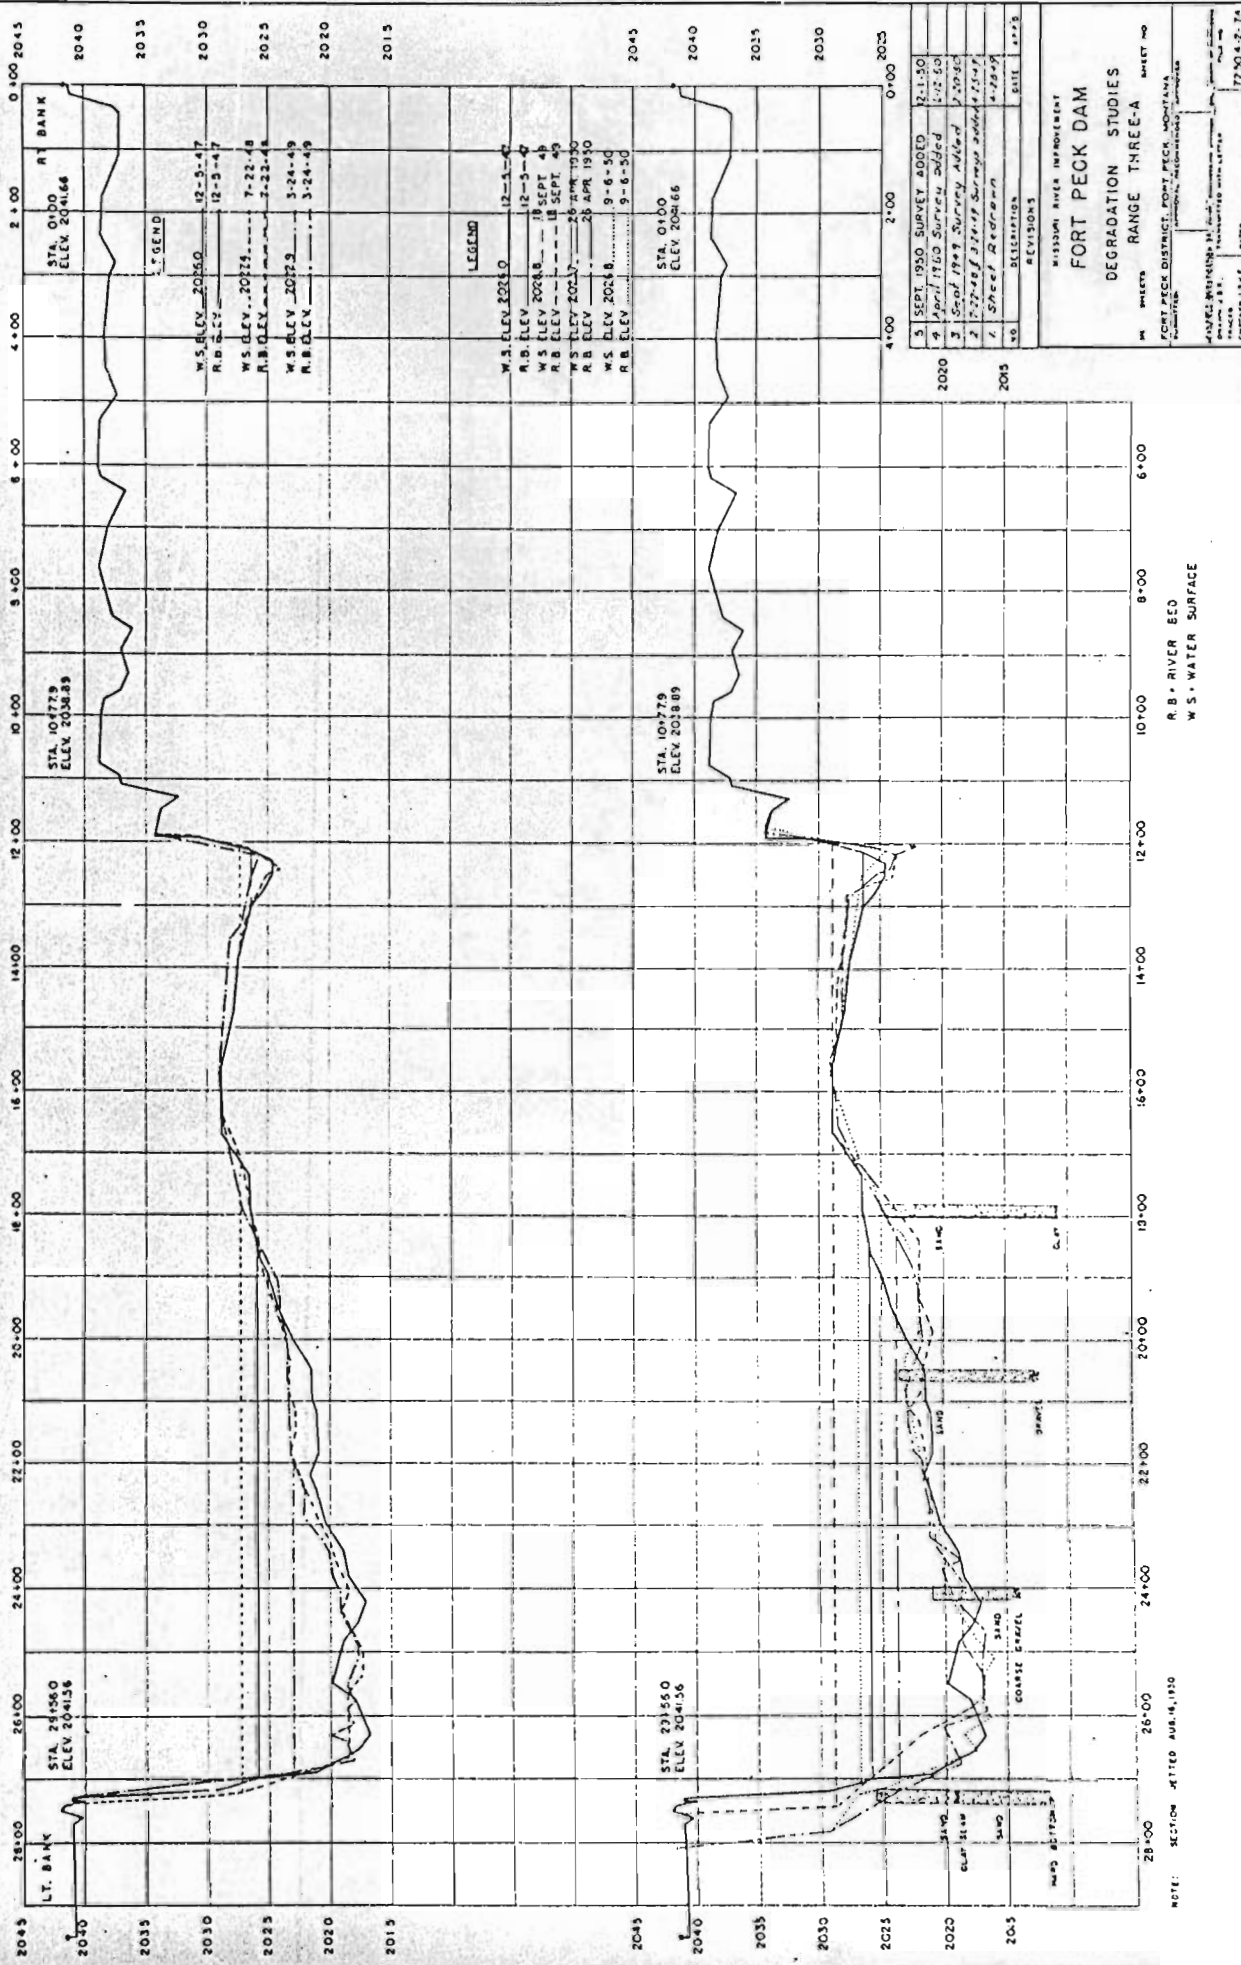

DATE: SEP 10 1950

 

W. S. - WATER SURFACE
R. B. - RIVER BED

LEGEND

WS ELEV 2022.4	5-27-36
RB ELEV	5-27-36
WS ELEV 2027.4	7-22-48
RB ELEV	7-22-48
WS ELEV 2021.8	3-24-49
RB ELEV	3-24-49

LEGEND

W.S. ELEV.	3-27-36
A.B. ELEV.	5-27-36
W.S. ELEV 20215	13-SEPT 49
A.B. ELEV	19-SEPT 49
W.S. ELEV 20217	26-APR 1950
A.B. ELEV	26-APR 1950
W.S. ELEV 20263	9-6-1950
A.B. ELEV	9-6-1950

5	SEPT. 1950 SURVEY ADDED	12-4-50	
4	APR. 1950 SURVEY ADDED	6-20-50	
3	SEPT. 49 SURVEY ADDED	2-20-50	
2	3-27-49 SURVEY ADDED	4-29-49	
04	ADDITIONAL	11-20	

MISSOURI RIVER IMPROVEMENT
FORT PECK DAM
DEGRADATION STUDIES



FORT PECK DISTRICT, FORT PECK, MONTANA

[illegible]

01 JUL 19

LT. BANK

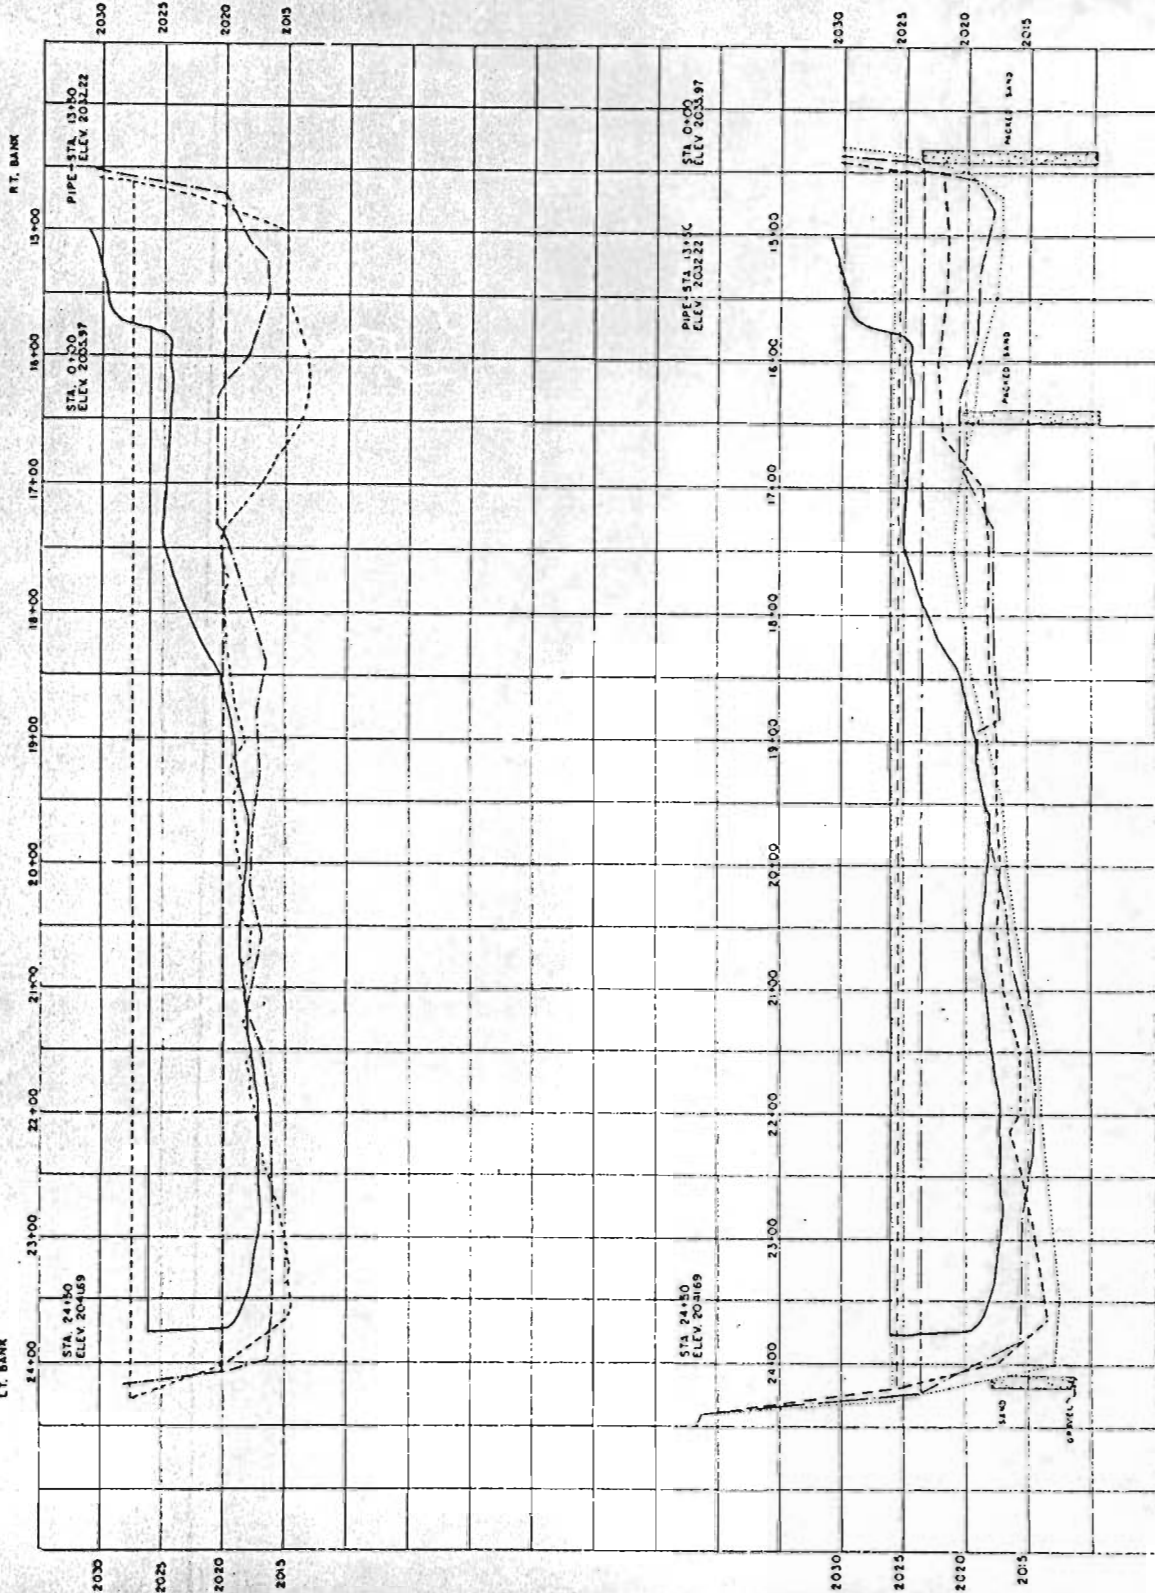

RT. BANK


LEGEND
 W.S. ELEV 2022.5-27-36


NO.	REVISIONS	DATE	BY

MISSOURI RIVER IMPROVEMENT
 FORT PECK DAM
 DEGRADATION STUDIES
 RANGE FIVE


NOTE: SECTION ATTACHED 10/1/50

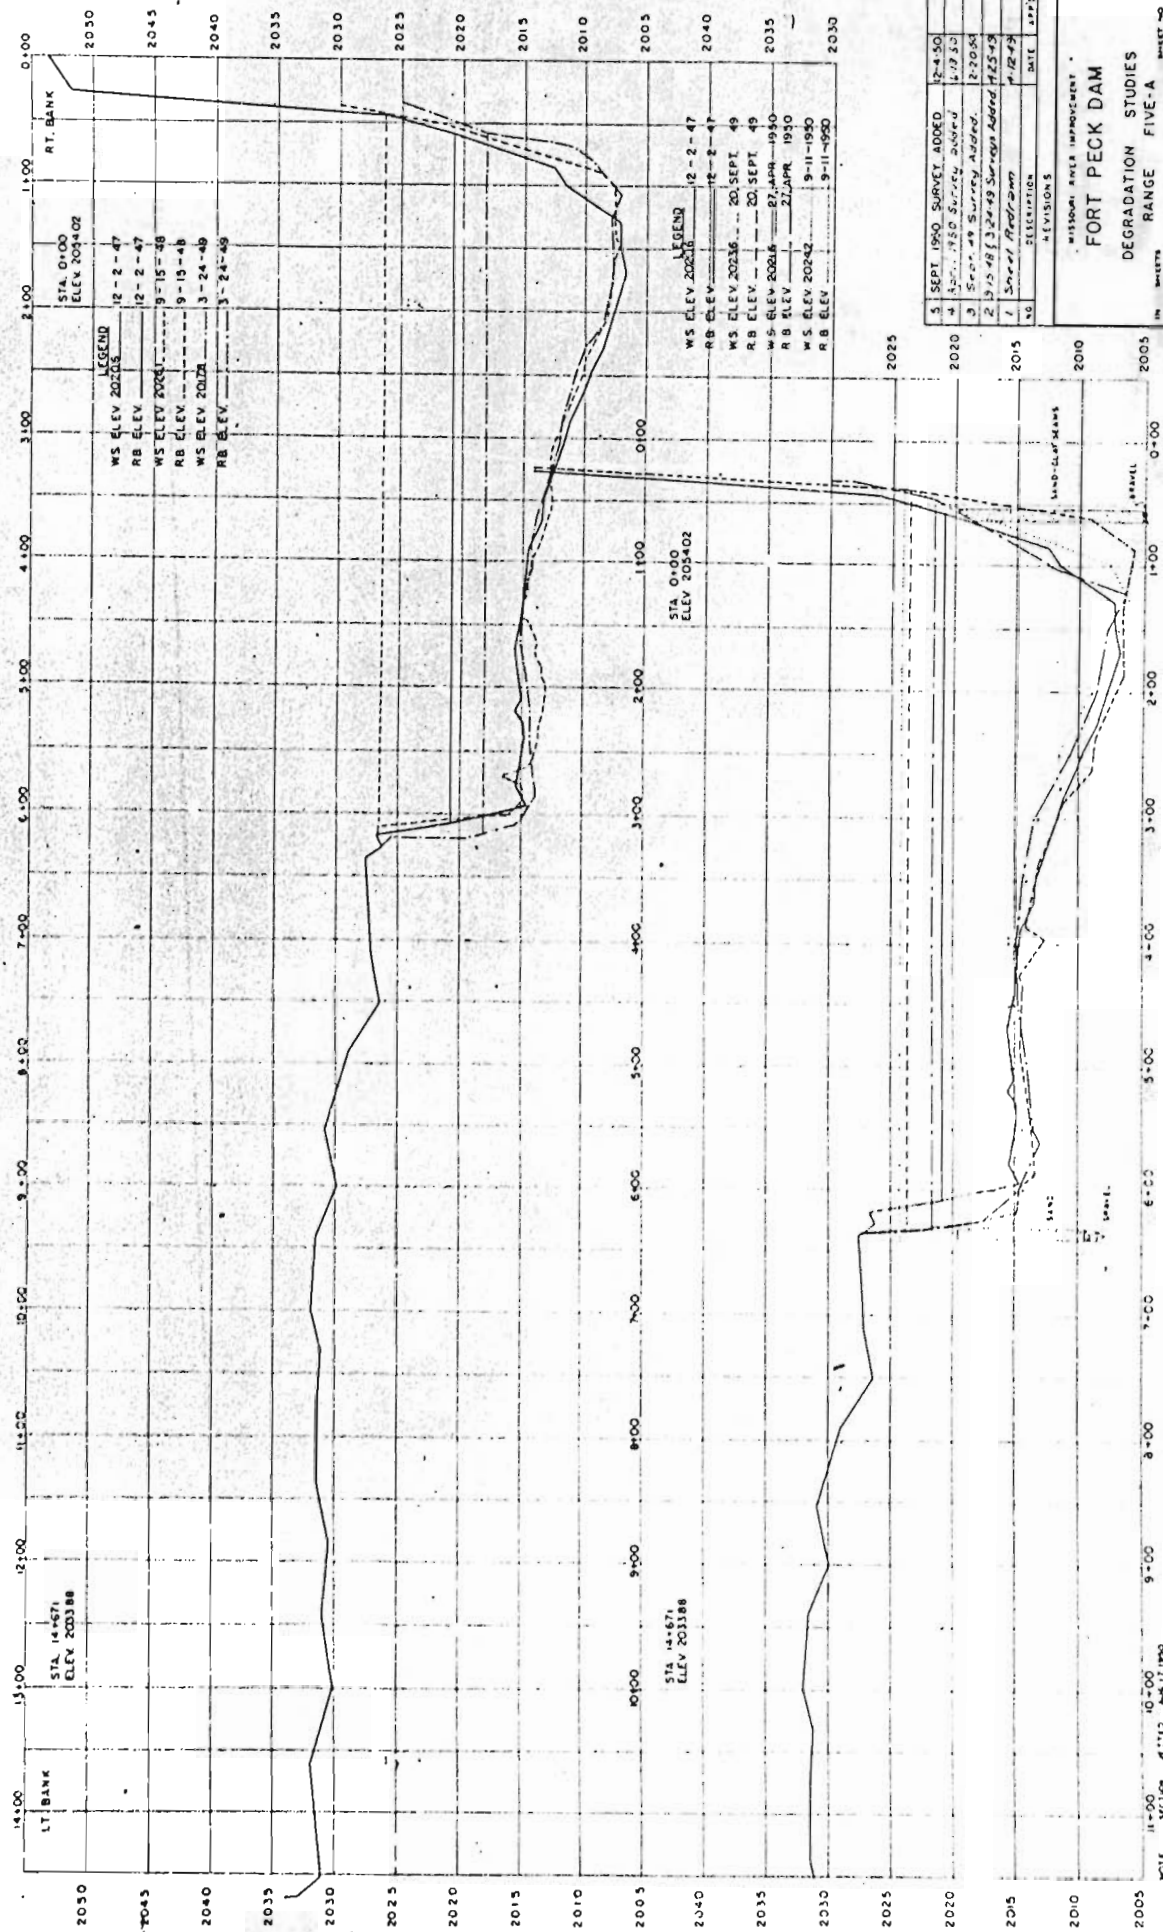

NO.	DESCRIPTION	DATE	APP'D
1	SEPT 1950 SURVEY ADDED	12-4-50	
2	APR 1950 SURVEY ADDED	4-19-50	
3	SEPT 49 SURVEY ADDED	2-20-55	
4	SEPT 48 (3-24-49) SURVEY ADDED	4-25-49	
5	SHORE PROTECTION	4-12-49	
6	REVISIONS		
7			
8			
MISSION: RIVER IMPROVEMENT
FORT PECK DAM
 DEGRADATION STUDIES
 RANGE FIVE-A
 SHEET NO.

FOR PECK DISTRICT, FORT PECK, MONTANA
 17504-2-77

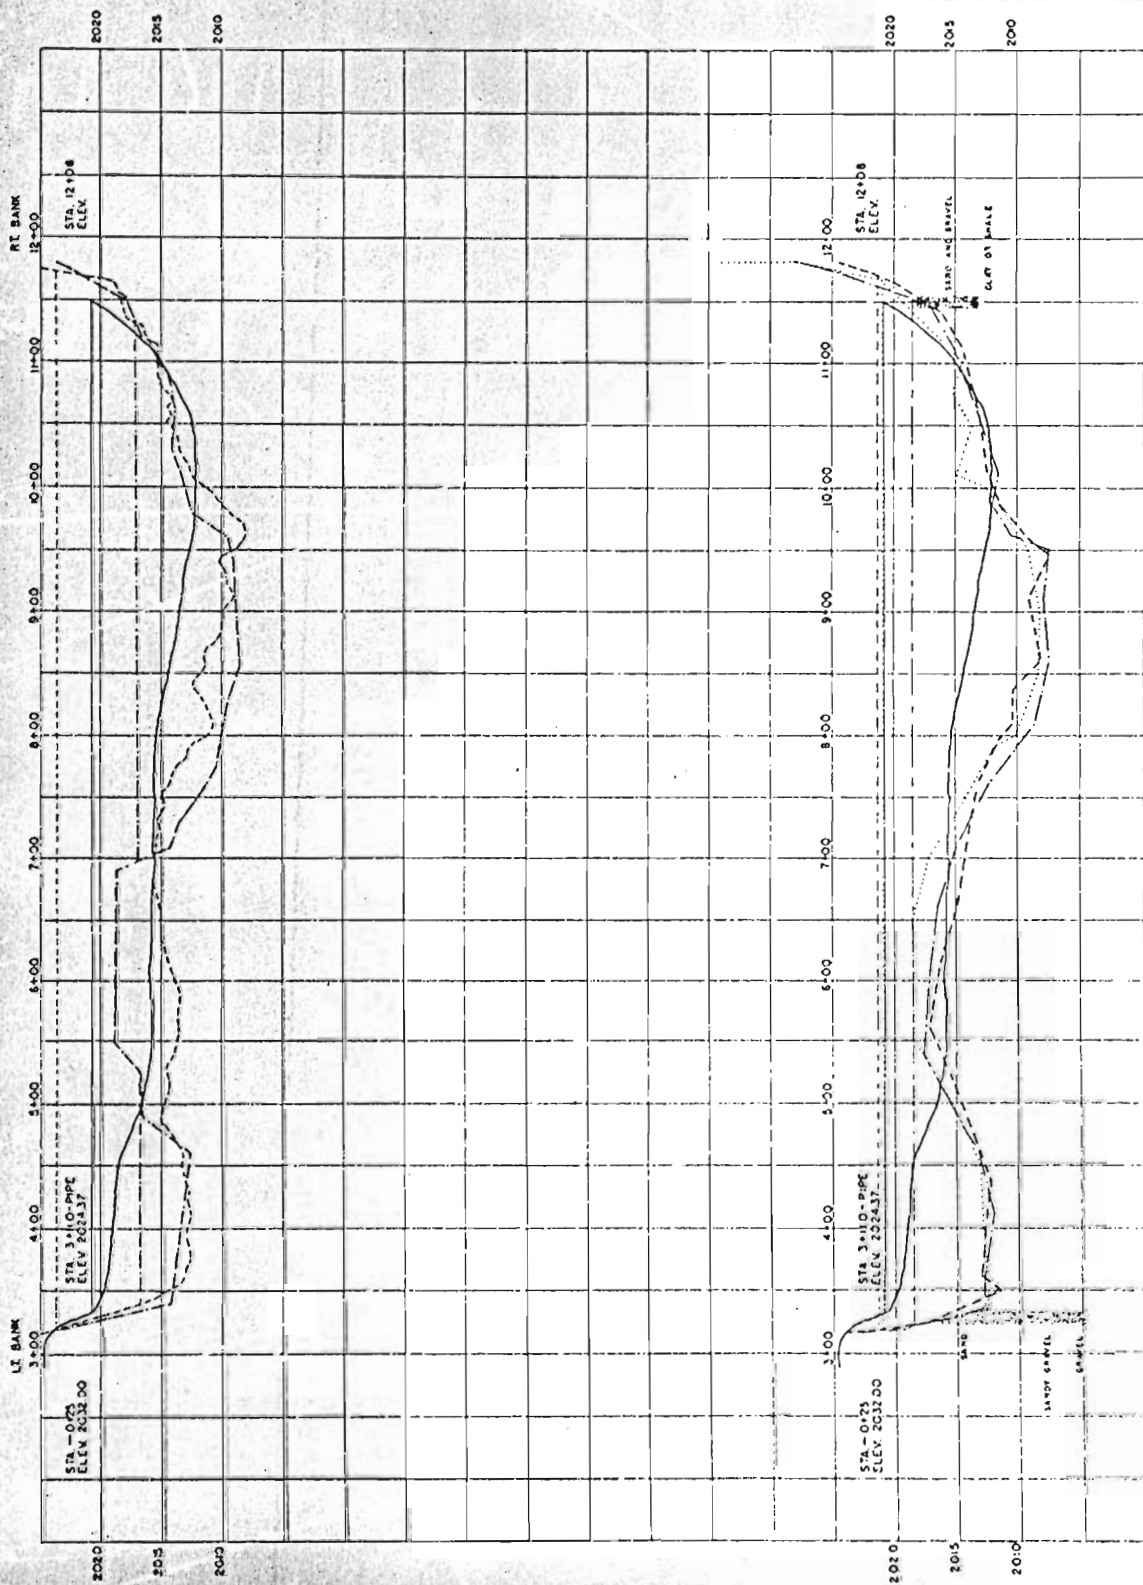

LEGEND
 W.S. ELEV 2020.8 9-28-36
 R.B. ELEV 2020.8 9-28-36
 W.S. ELEV 2021.1 9-15-48
 R.B. ELEV 2021.1 9-15-48
 W.S. ELEV 2021.6 3-28-49
 R.B. ELEV 2021.6 3-28-49

LEGEND
 W.S. ELEV 2020.8 9-28-36
 R.B. ELEV 2020.8 9-28-36
 W.S. ELEV 2021.1 20 SEPT 49
 R.B. ELEV 2021.1 20 SEPT 49
 W.S. ELEV 2021.6 27 APR 1950
 R.B. ELEV 2021.6 27 APR 1950
 W.S. ELEV 2020.8 9-14-50
 R.B. ELEV 2020.8 9-14-50

NO.	REVISIONS	DATE	BY
1	Original	10-1-50	WJH
2	Survey added	2-10-51	WJH
3	Survey added	2-10-51	WJH
4	Survey added	2-10-51	WJH
5	Survey added	2-10-51	WJH

MISSOURI RIVER IMPROVEMENT
FORT PECK DAM
 DEGRADATION STUDIES
 RANGE SIX

NO. SHEETS
 SHEET NO.
 FORT PECK DISTRICT, FORT PECK, MONTANA
 PROJECT NO. 7200-2-15
 DRAWN BY
 CHECKED BY
 DATE 7-2-51

NOTE: SECTION CUTTED AUG 17, 1950
 PROFILE INDICATES CLAY OR SHALE BED TO RIGHT OF STA 8+10

W.S. - WATER SURFACE
 R.B. - RIVER BED



W. S. LLEY, 20334 12-3-47
R. B. LLEY 12-3-47
W. S. LLEY, 20310 9-16-49
R. B. LLEY 9-16-49
W. S. LLEY, 20338 1-19-49
R. B. LLEY 1-19-49

642037

W. S. ELEV. 2004.4 12-3-47
R. B. ELEV. 18-3-47
W. S. ELEV. 2012.4 25 SEP 49
R. B. ELEV. 18-3-49
W. S. ELEV. 2016.4 27 APR 99
R. B. ELEV. 18-3-99
W. S. ELEV. 2018.0 3-19-50
R. B. ELEV. 18-3-50



FCRT PECK DAM

DEGRADATION STUDIES

RANGE SIX - 2


CM 112-44







 


5	DEPT. INFO SURVEY 1 DTD	7-1-90
4	April 90 Survey Added	9:22-90
3	Sept 49 Survey Added	7-21-90
2	9-22-49 & 1-10-49 Survey Added	9-20-90
1	Survey Information	1-25-90
0	DESCRIPTION	Sub

REVISIONS



FORT PECK DAM

DEGRADATION STUDIES

RANGE SIX-B




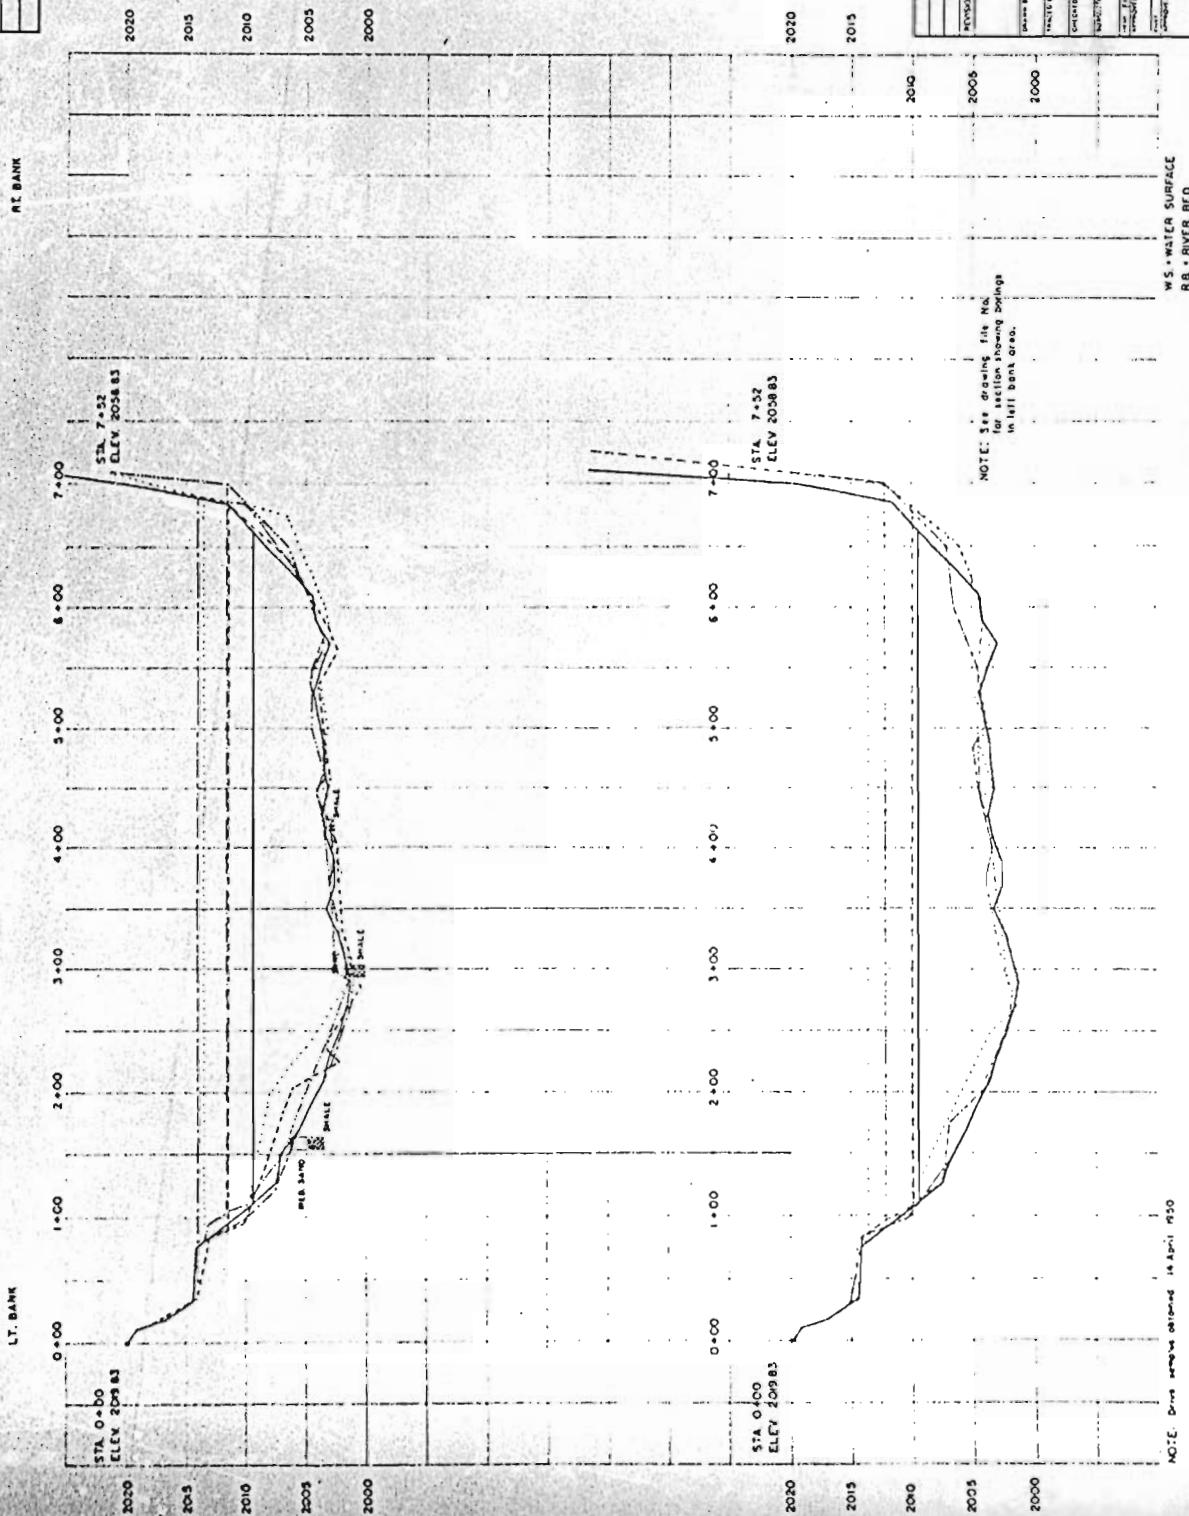

NOTE: See drawing file No.
for section showing borings
in left bank area.

NOTE: Drive screws obtained 14 April 1950

[illegible]

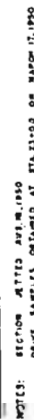

R.D. - RIVER BEC


LEGEND


W.S.	ELEV. 2008.7	12-11-47
R.B.	ELEV.	12-11-47
W.S.	ELEV. 2012	9-17-48
R.B.	ELEV.	9-17-48
W.S.	ELEV. 2008.4	1-20-49
R.B.	ELEV.	1-20-49

W. S. ELEV.	2006.7	12-11-47
R. D. ELEV.		12-11-47
W. S. ELEV.	2003.2	9-30-49
R. D. ELEV.		9-30-49
W. S. ELEV.	2006.7	4-28-50
R. D. ELEV.		4-28-50
W. S. ELEV.	2006.7	9-27-50
R. D. ELEV.		9-27-50

NO.	DESCRIPTION	DATE
1	Sheet Metal	10/29/58
2	728-408 1/20-29 Survey	11/22/58
3	Sept. 49 Survey added	1/20/59
4	April '50 Survey added	5/31/59
5	SEPT. 1950 SURVEY ADDED	7-8-50

MISSION: RITE IMPROVEMENT
FORT PECK DAM
DEGRADATION STUDIES
RANGE SIX-C

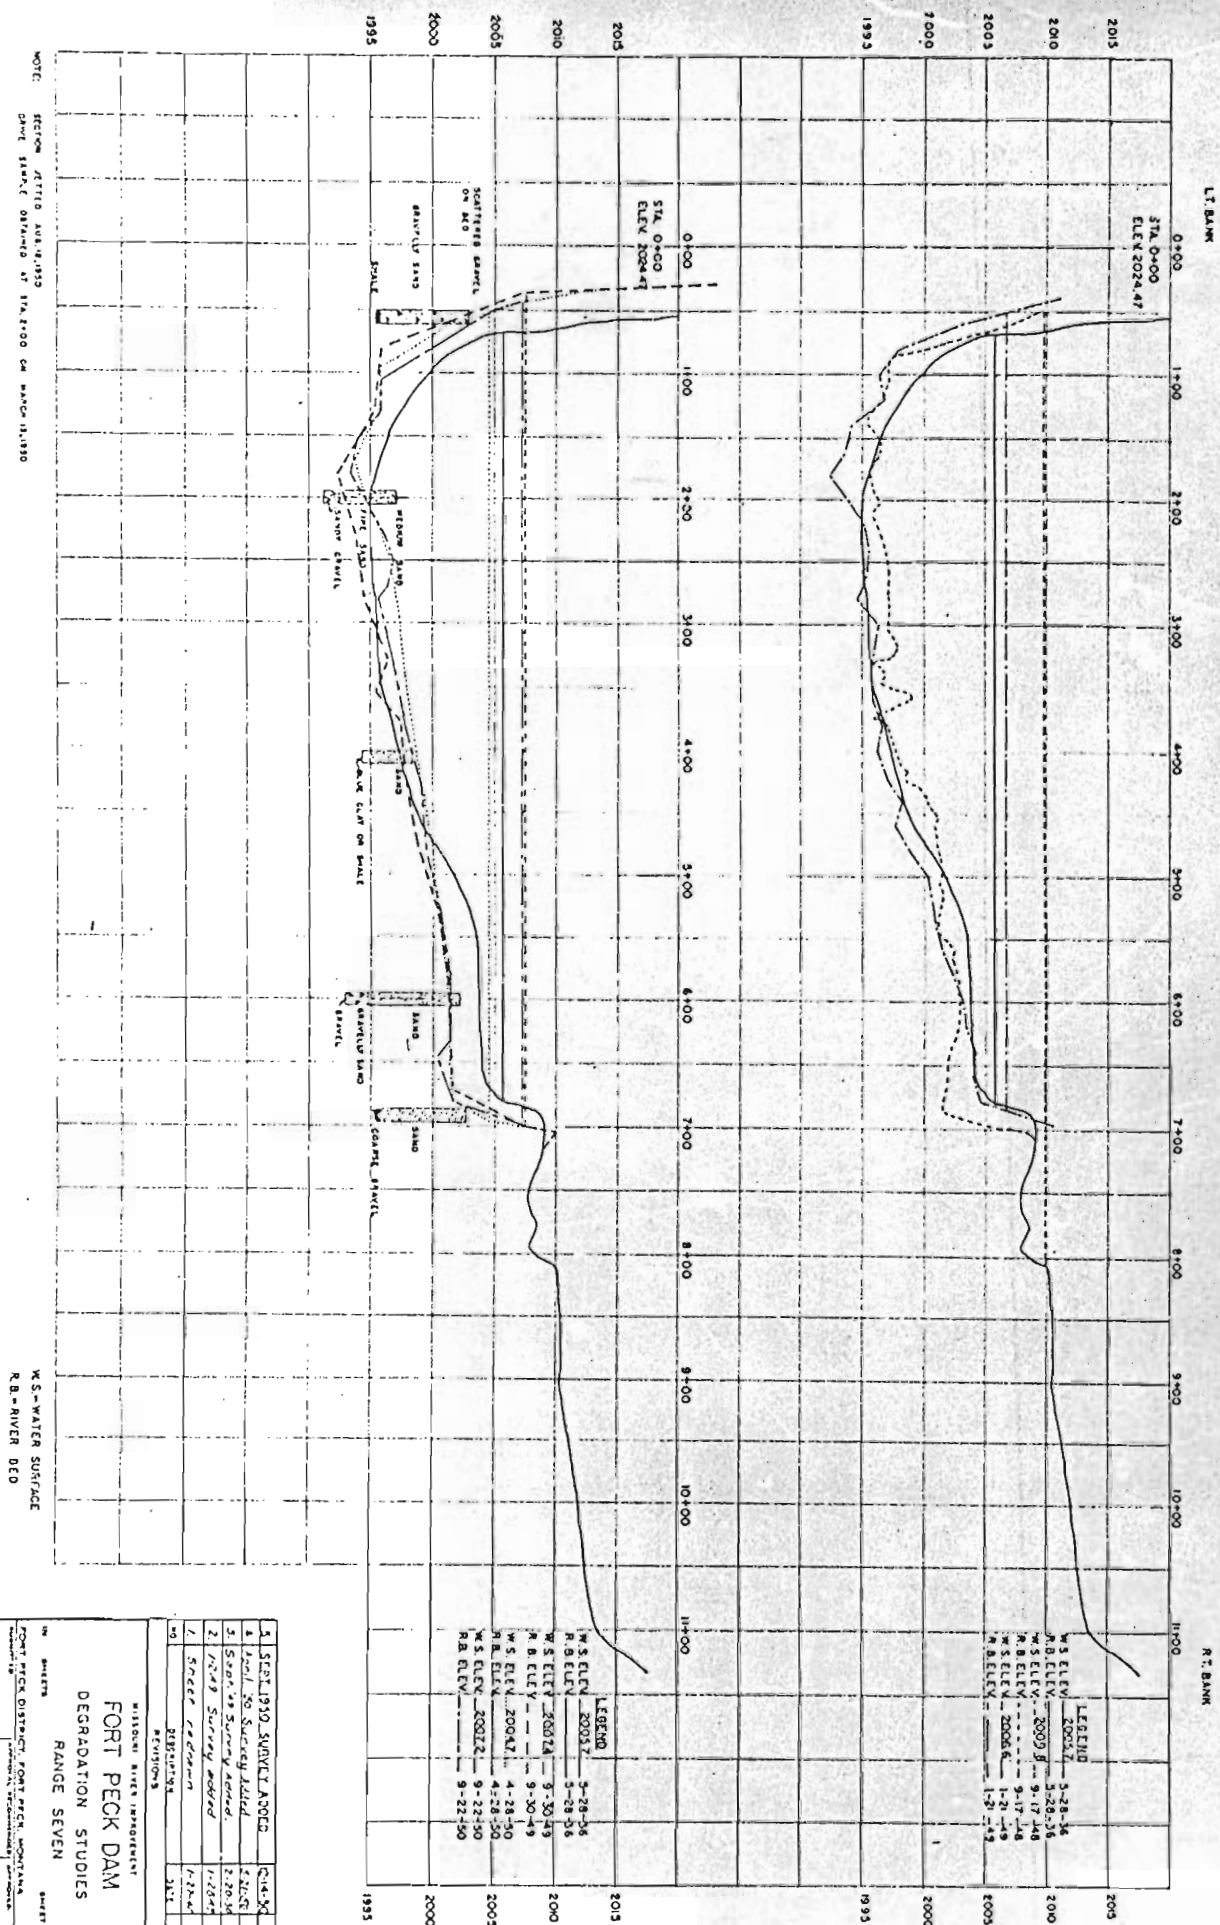

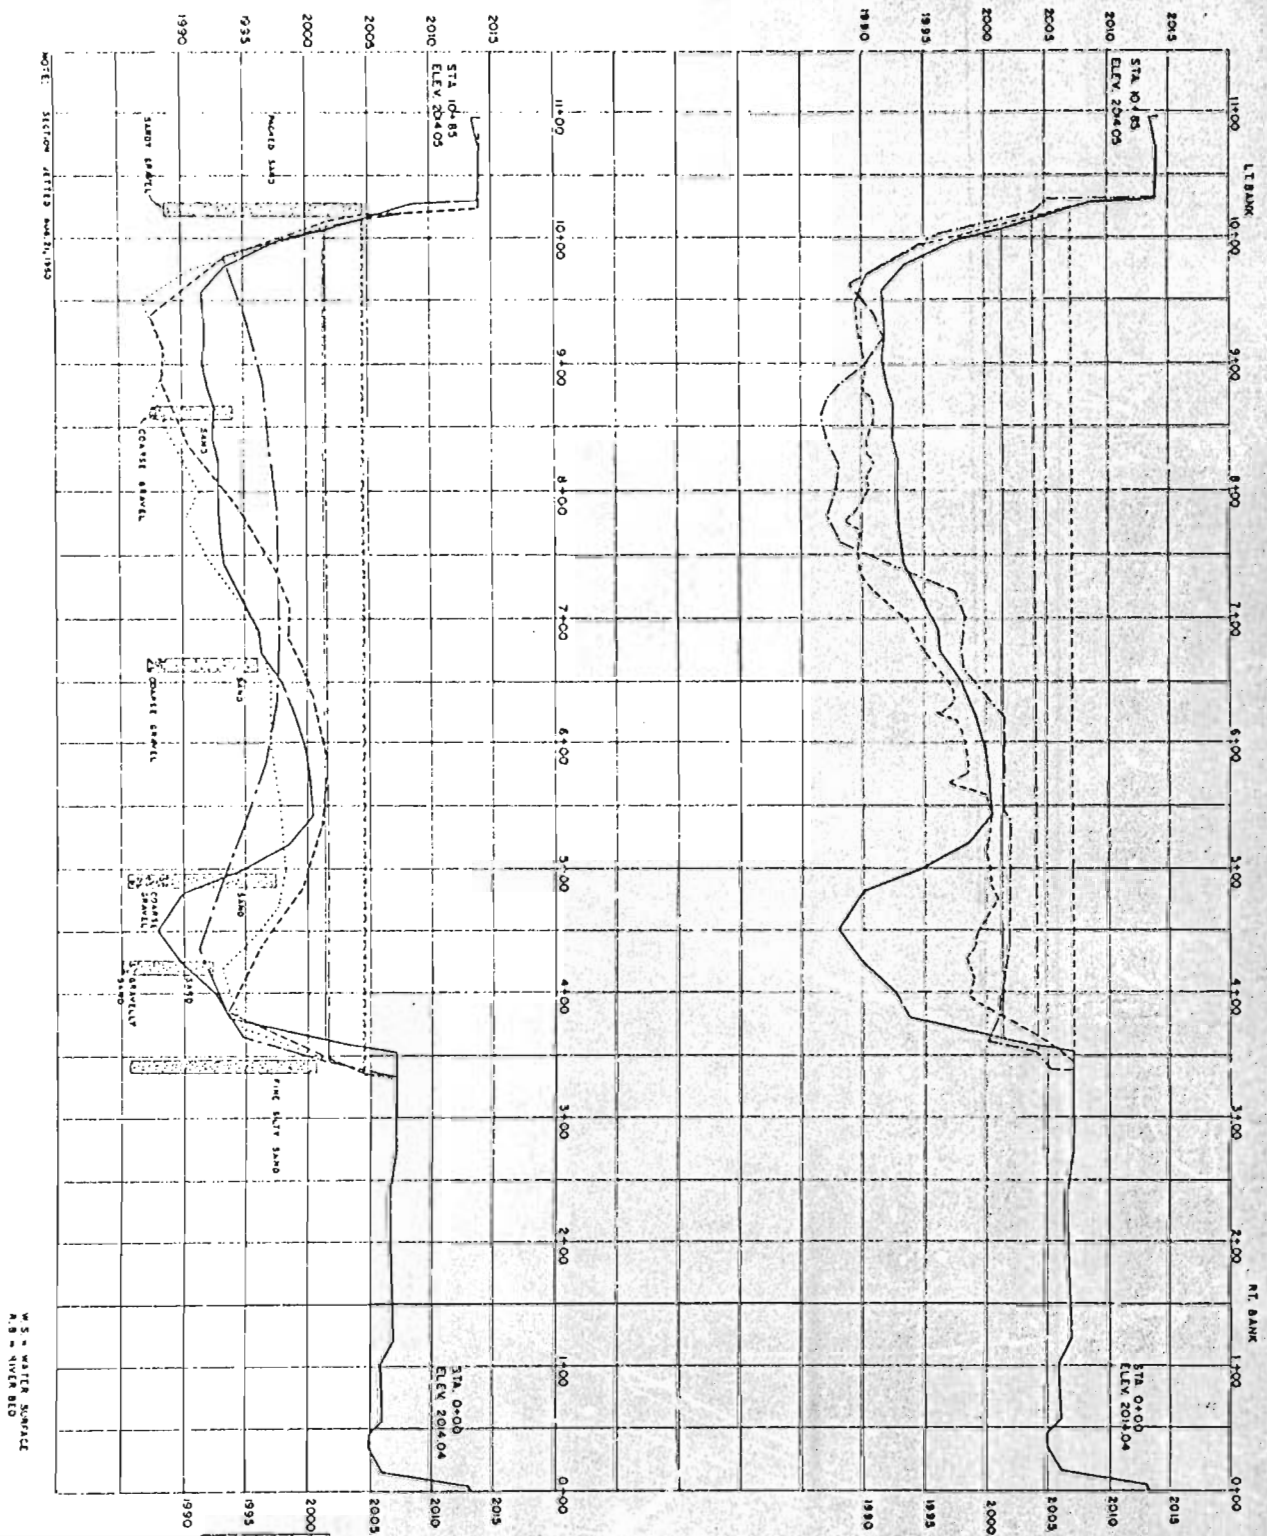


LEGEND
 WS ELEV - 1004.12-0-47
 RB ELEV - 1004.12-0-47
 WS ELEV - 2002.9-27-44
 RB ELEV - 2002.9-27-44
 WS ELEV - 2004.1-21-49
 RB ELEV - 2004.1-21-49

LEGEND
 WS ELEV - 1004.12-0-47
 RB ELEV - 1004.12-0-47
 WS ELEV - 2004.6-30-49
 RB ELEV - 2004.6-30-49

NO.	DATE	DESCRIPTION	BY	CHKD	APPD
1	SEPT 1930	SURVEY ADDED			
2	SEPT 1930	SURVEY ADDED			
 FORT PECK DAM
 DEGRADATION STUDIES
 RANGE SEVEN-A
 SHEET NO. 1

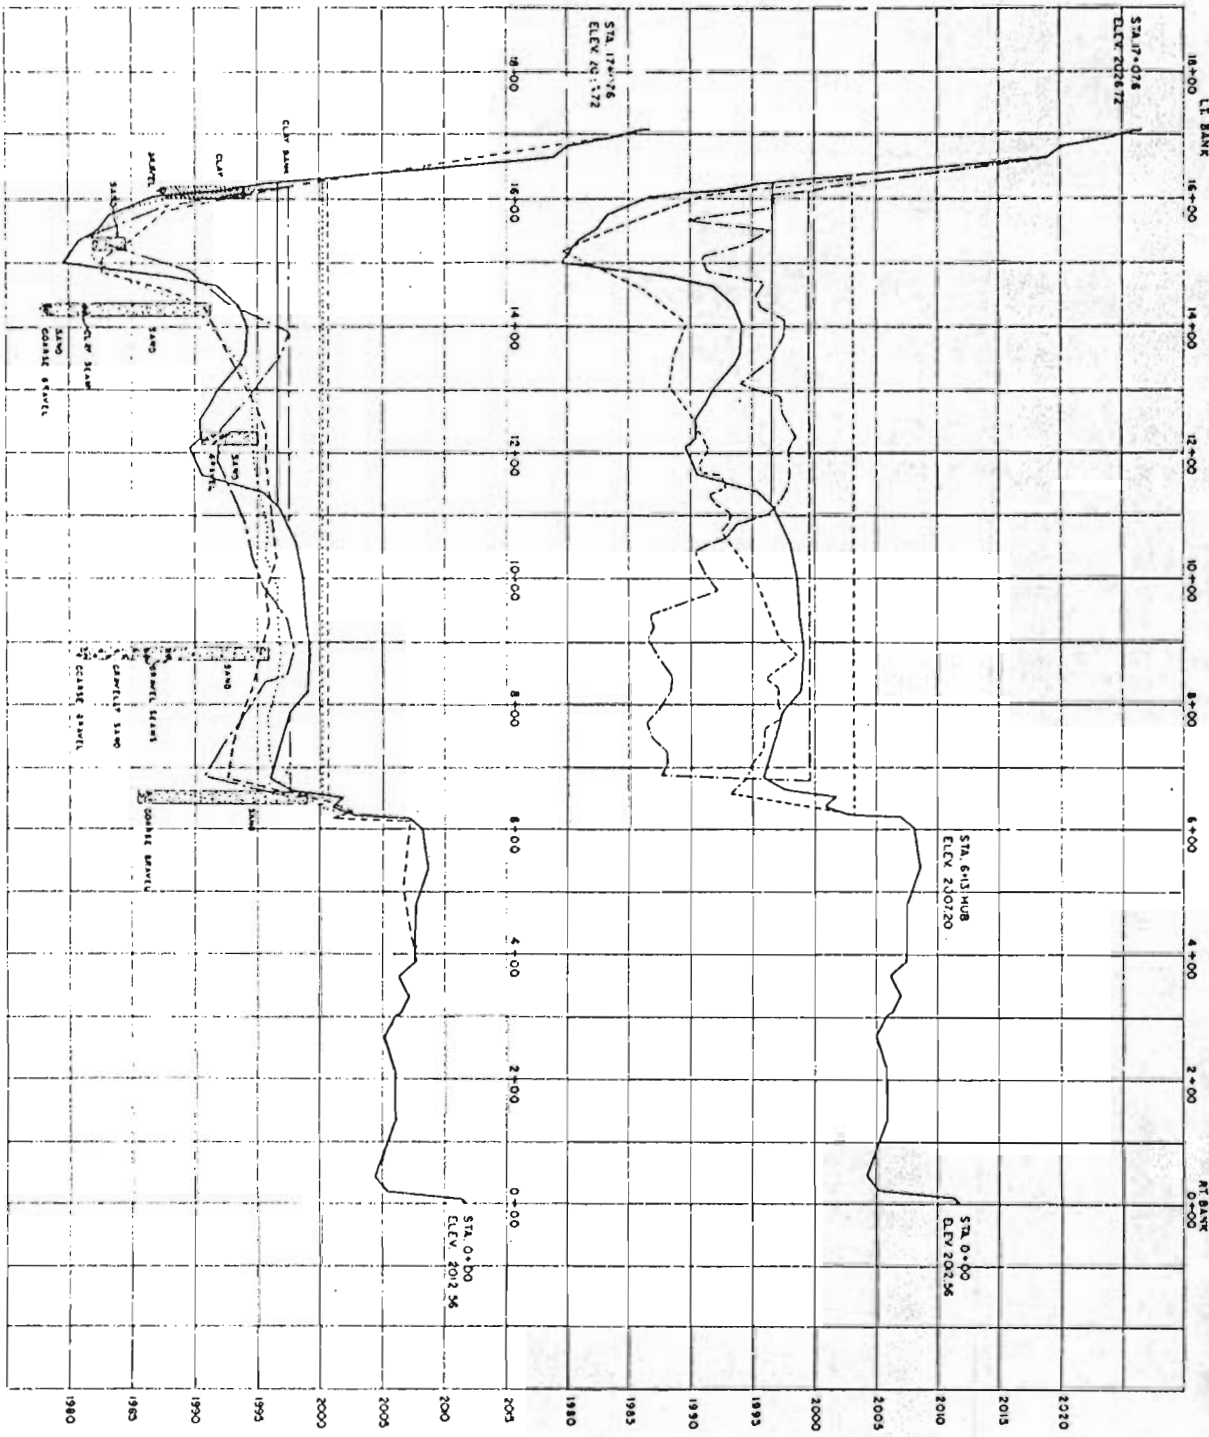




5	Sept 1980 Survey Added	10-2-90
4	Nov 1980 Survey Added	1-17-90
3	Sept 48 Survey Added	2-10-48
2	Sept 48 Survey Added	1-20-48
1	Sept 48 Survey Added	1-20-48

 FORT PECK DAM
 DEGRADATION STUDIES
 RANGE SEVEN-B

NOTE: SECTION ADDED JAN. 1980
 W.S. WATER SURFACE
 R.B. RIVER BED



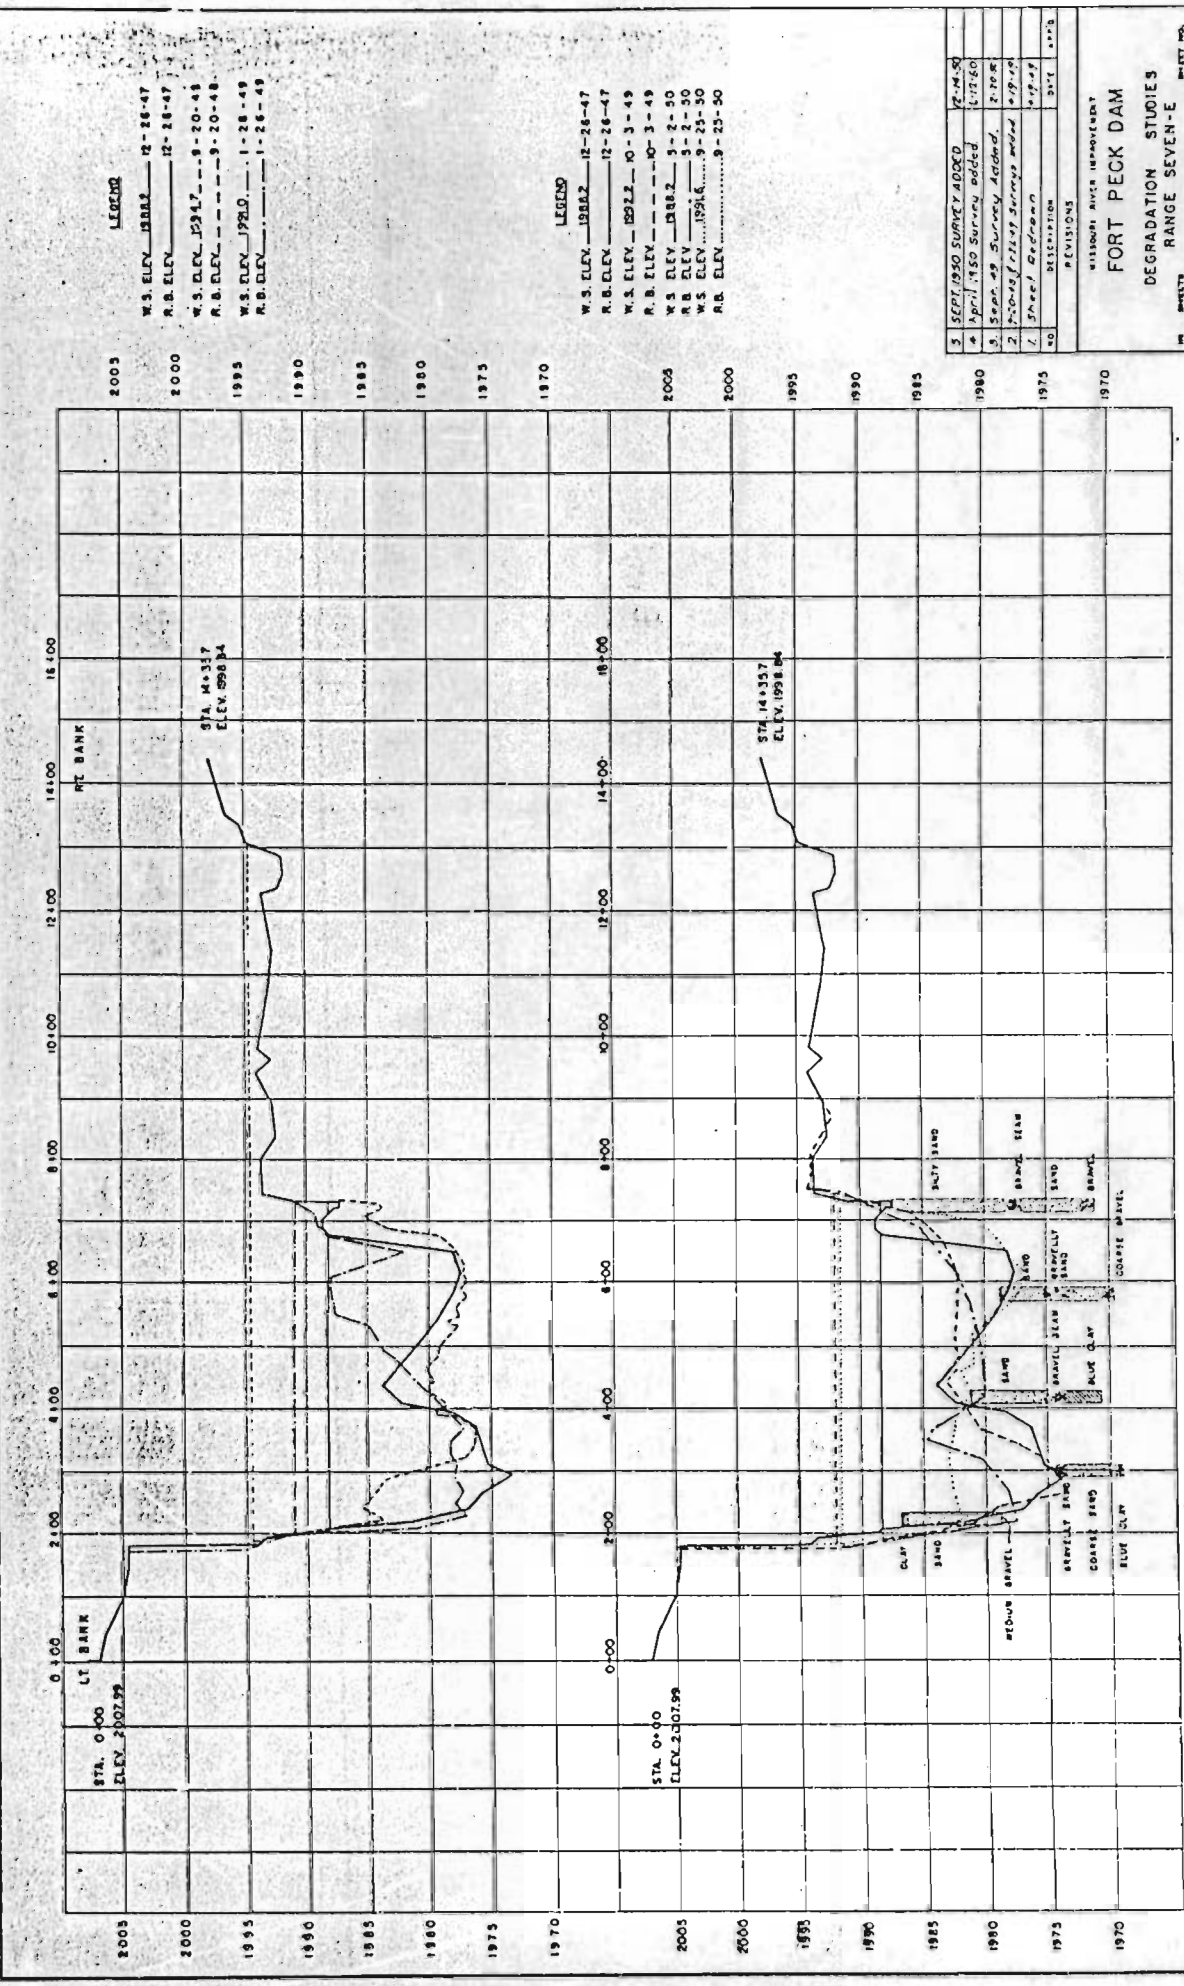

LEGEND

W.S. ELEV. 1988.2 12-26-47
R.B. ELEV. 12-26-47
W.S. ELEV. 1991.7 9-20-48
R.B. ELEV. 9-20-48
W.S. ELEV. 1992.0 1-28-49
R.B. ELEV. 1-28-49

LEGEND

W.S. ELEV. 1988.2 12-26-47
R.B. ELEV. 12-26-47
W.S. ELEV. 1992.2 10-3-49
R.B. ELEV. 10-3-49
W.S. ELEV. 1988.2 9-20-50
R.B. ELEV. 9-20-50
W.S. ELEV. 1991.6 9-23-50
R.B. ELEV. 9-23-50


NO.	DESCRIPTION	DATE	BY

REVISIONS	
NO.	DESCRIPTION
1	Sheet Addition

FORT PECK DAM
DEGRADATION STUDIES
RANGE SEVEN-E

IN SHEETS
FORT PECK DISTRICT FORT PECK, MONTANA
PROJECT NO. 7150-4-2-7
SHEET NO. 1

NOTE: SECTION JETTED AUG. 22, 1950

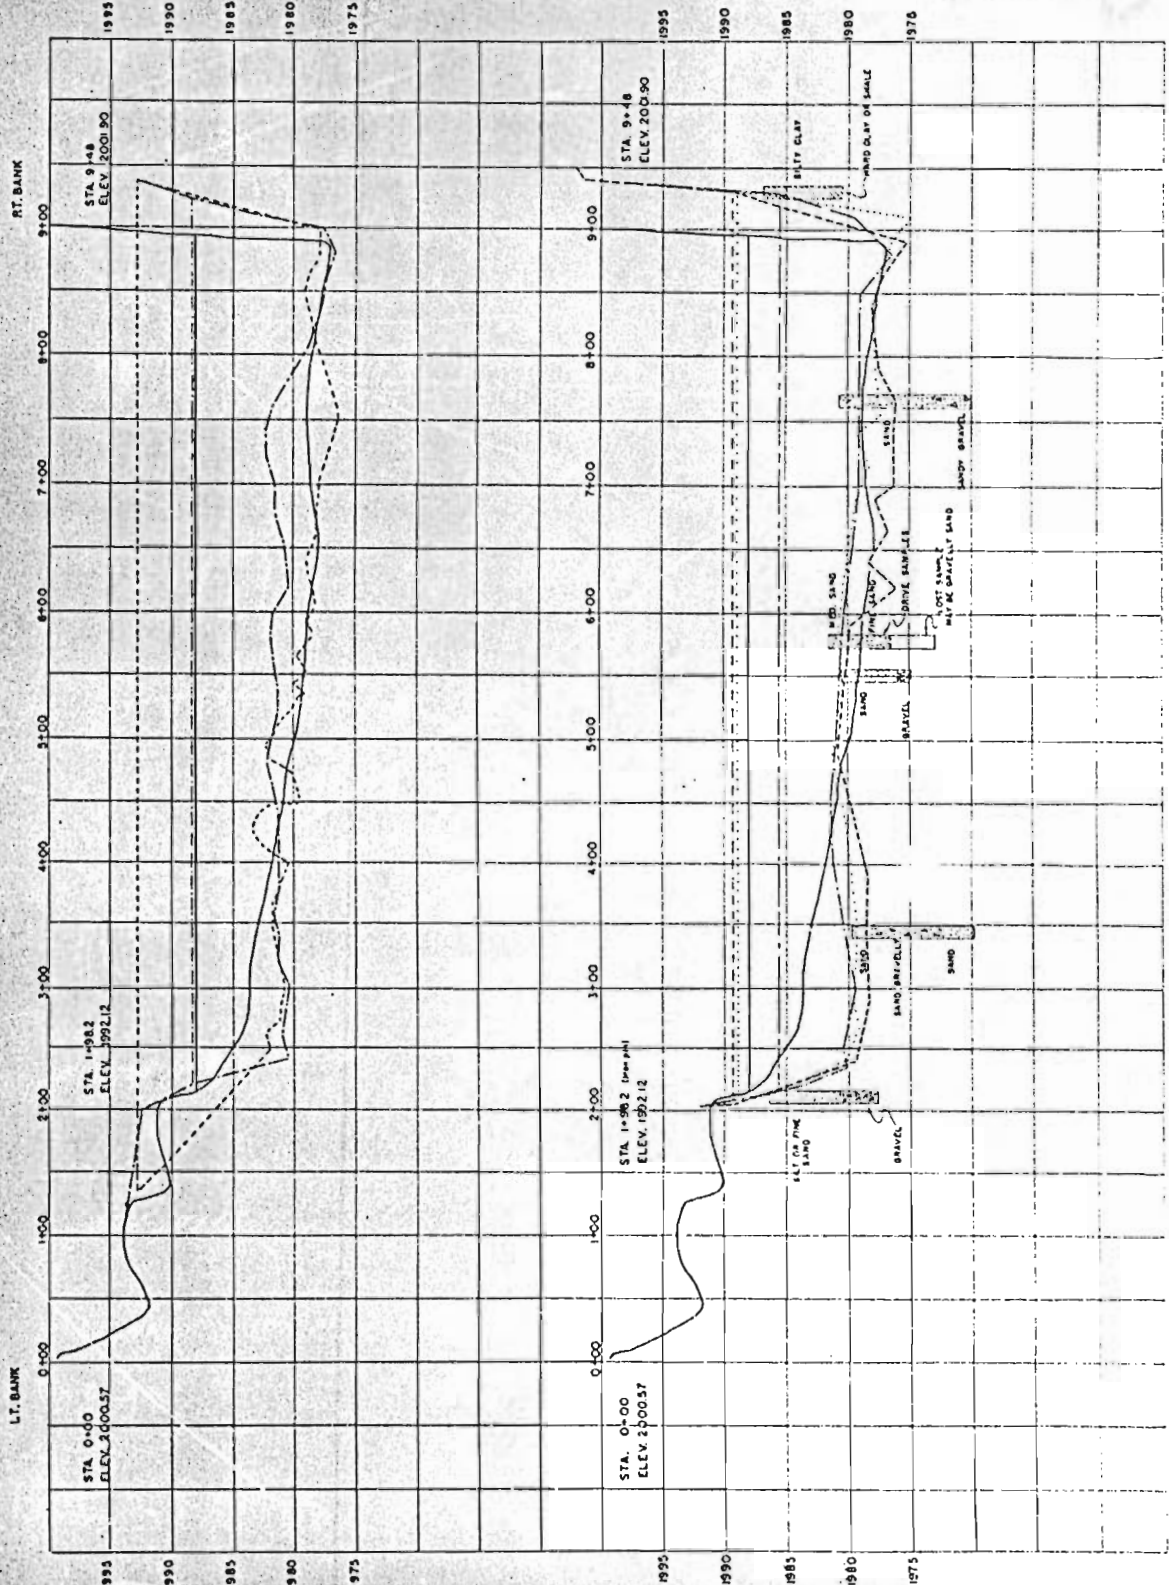

LEGEND














1	SEPT 1990 SURVEY ADDED	12-30-90
2	1982/1990 SURVEY ADDED	1-10-91
3	SEPT 99 SURVEY ADDED	12-30-99
4	1982/99 SURVEY ADDED	1-10-01

MISSOURI RIVER IMPROVEMENT

FORT PECK DAM

DEGRADATION STUDIES

RANGE EIGHT

NO. SHEETS


PROJECT NO.

7504-2-133

DATE

7/9/99

NOTE: SECTION ADDED ON 12 AUGUST 1995. DRIVE SAMPLES OBTAINED AT STA. 3+50 ON 23 MAR 1990 (SHOWN AT STA. 3+71)

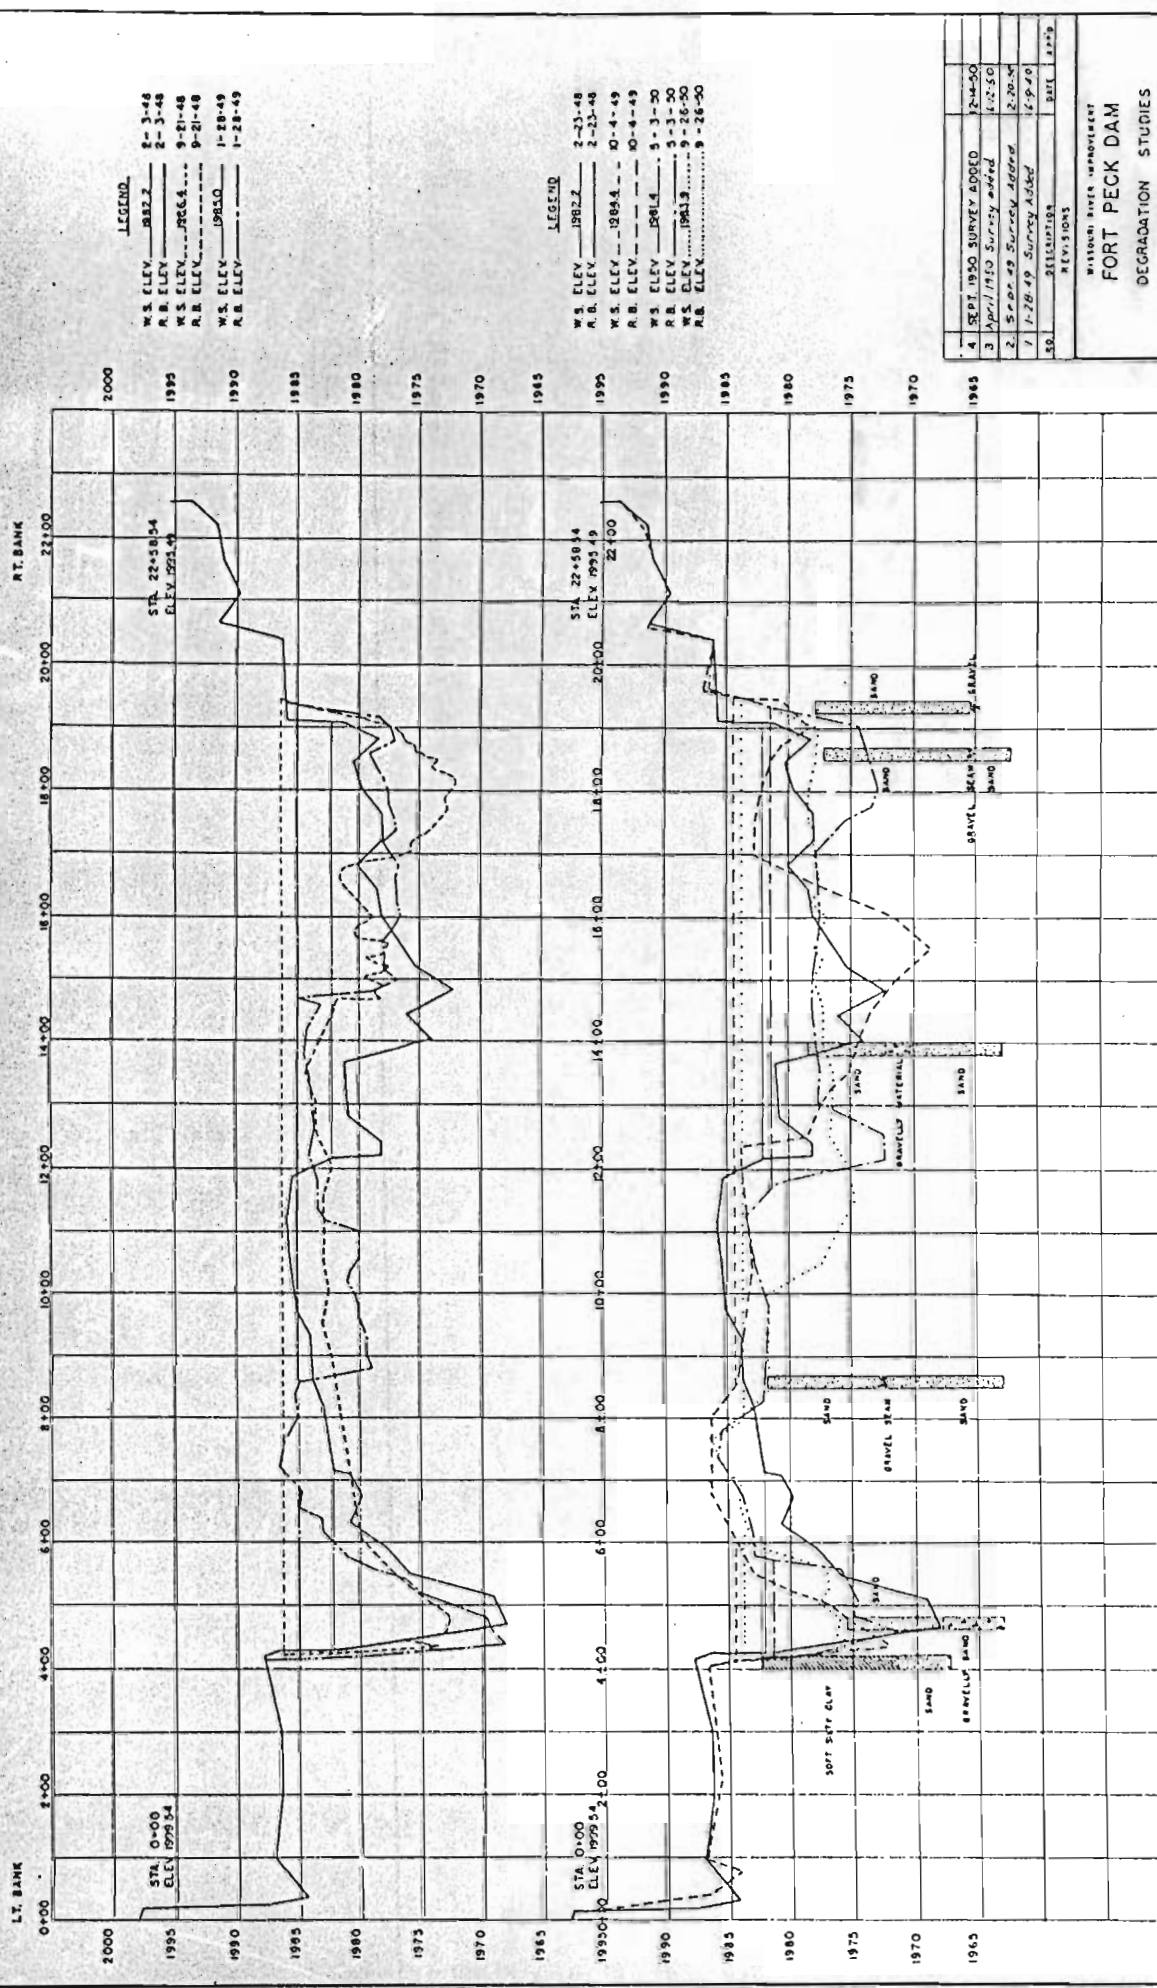

NOTE: SECTION JETTED MARCH 1990


LEGEND


NO.	REVISIONS	DATE	BY

 FORT PECK DAM
 DEGRADATION STUDIES
 RANGE NINE

SHEET NO.	7250-1-2-49

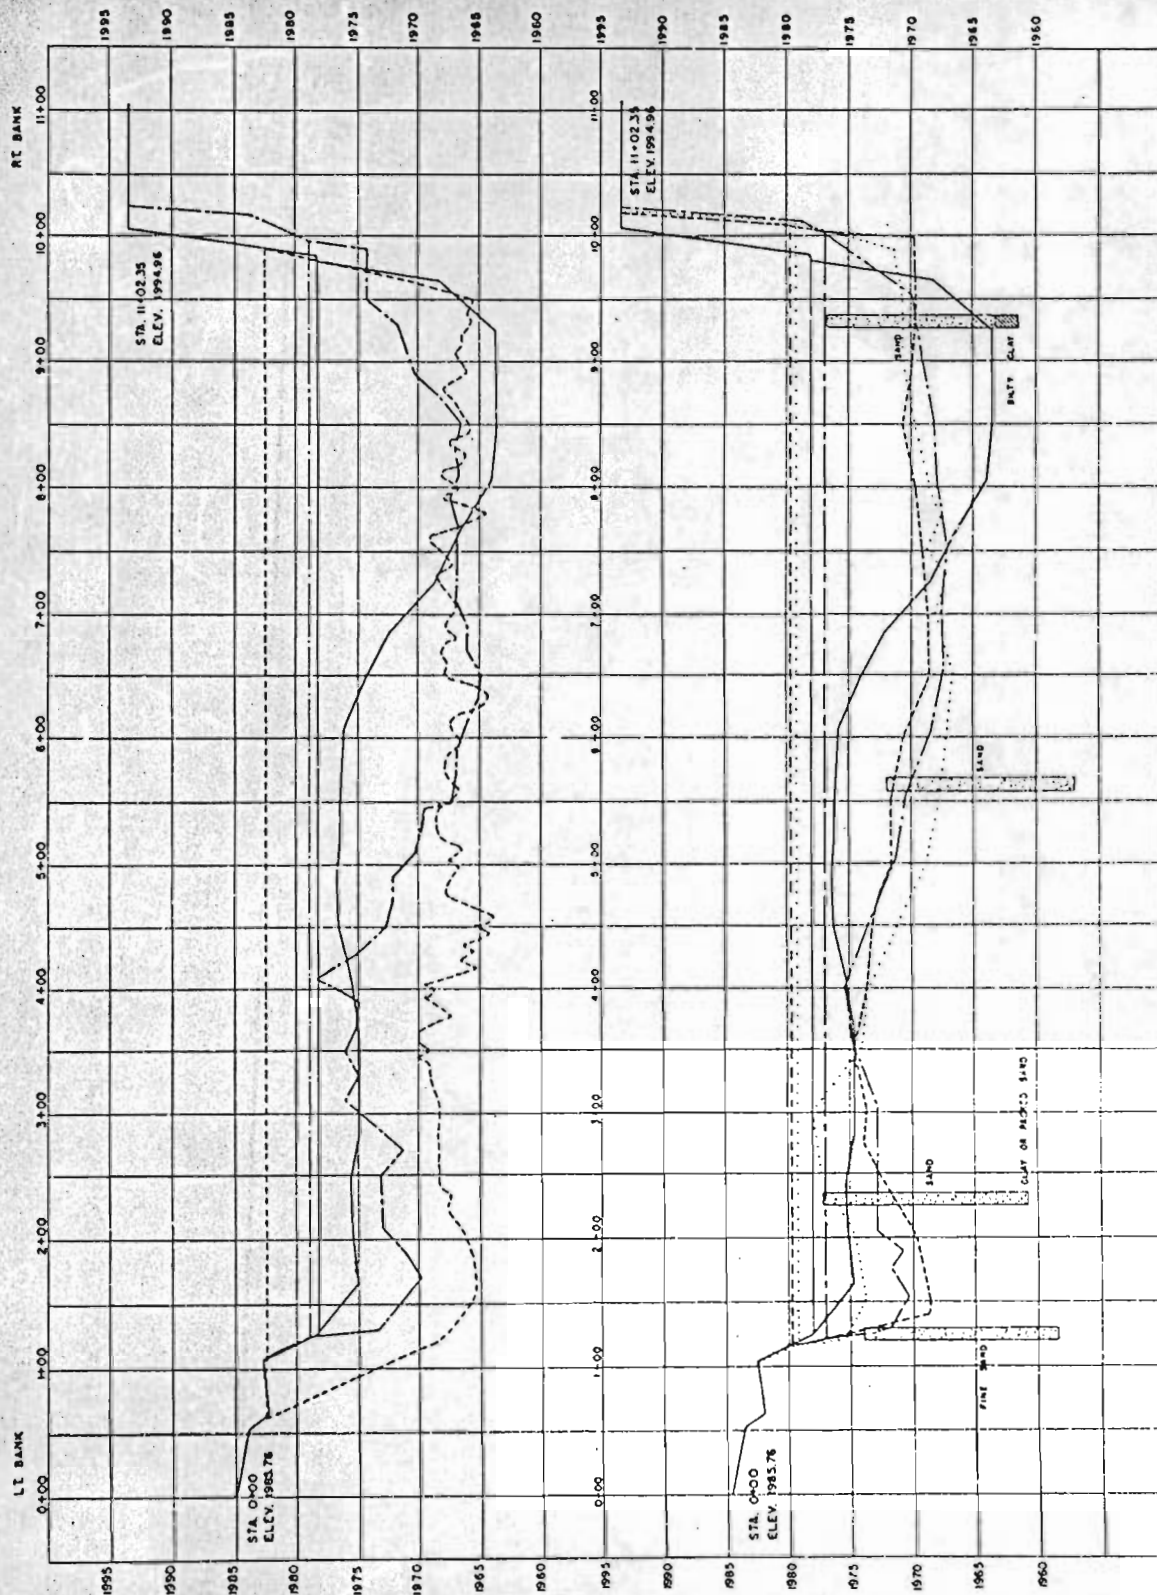

LEGEND




4	SEPT 1950 SURVEY ADDED	7-4-50
3	APRIL 1950 SURVEY ADDED	6-19-50
2	SEPT 49 SURVEY ADDED	2-10-49
1	1-31-49 SURVEY ADDED	1-31-49
0	DISCUSSION	DATE 1-1-53
REVISIONS		

MISSOURI RIVER IMPROVEMENT
 FORT PECK DAM
 DEGRADATION STUDIES
 RANGE TEN

PROJECT NO. 7204-2-90

DATE 7-1-53


BY 7204-2-90

NOTE: SECTION JETTED NOV 23, 1950



LEGEND		3-31-50 ORIGINAL	3-31-50 ORIGINAL
W S. ELEV.	19657		
R. B. ELEV.			
W S. ELEV.	1745.9	10-2-57	
R. B. ELEV.		10-2-52	
W S. ELEV.	1870.6	11-9-53	
R. B. ELEV.		11-9-53	
W S. ELEV.	1974.7	9-30-54	
R. B. ELEV.		9-30-54	
W S. ELEV.			
R. B. ELEV.			

[illegible]

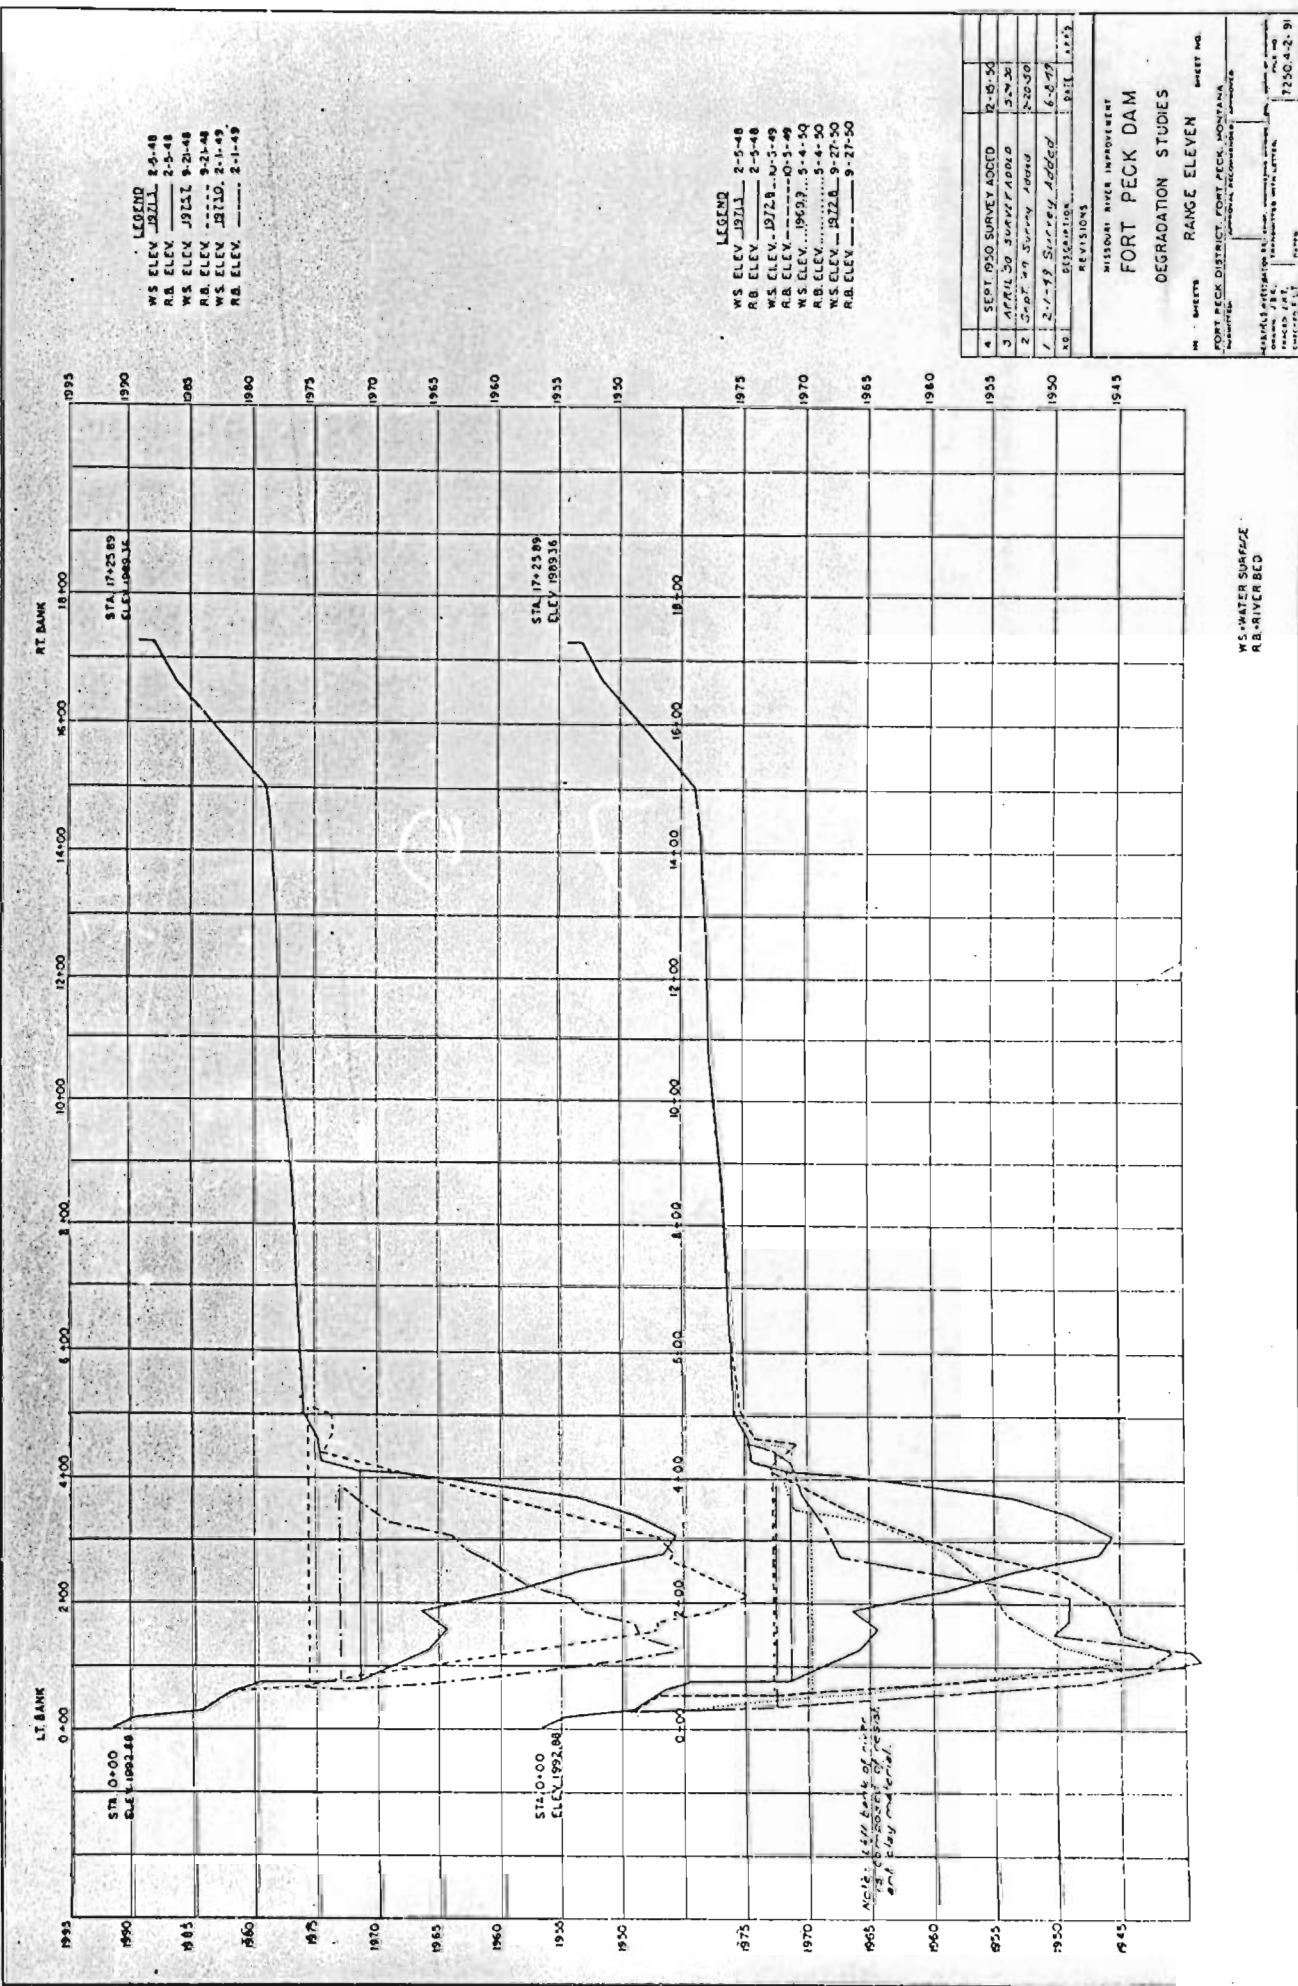



LEGEND
WS ELEV 1971.1 2-5-48
RB ELEV 1971.1 2-5-48



MISSOURI RIVER IMPROVEMENT
FORT PECK DAM
DEGRADATION STUDIES
SHEET NO. 7250.4-2-31
DATE: 1950.4.2.31

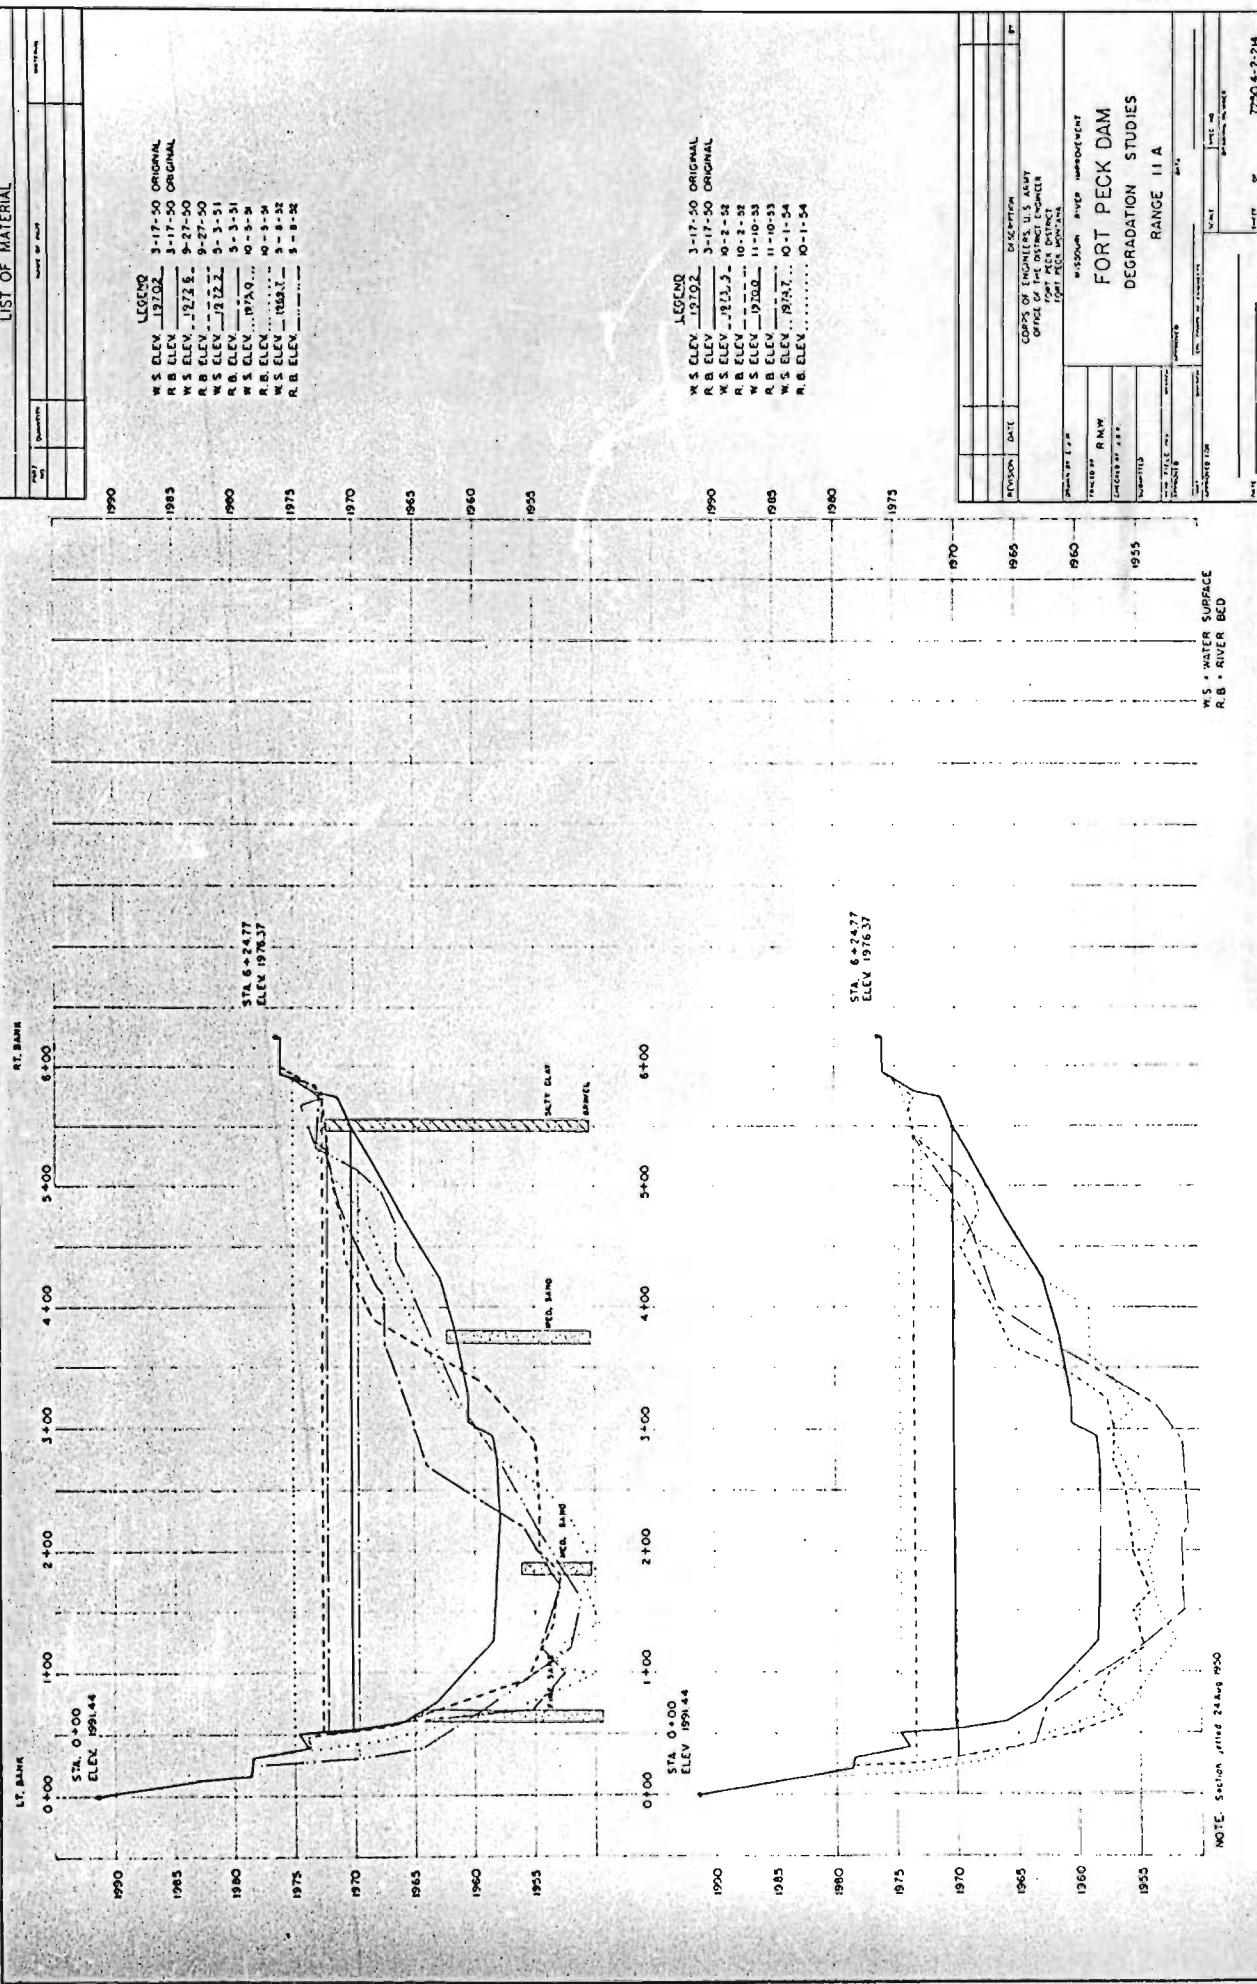

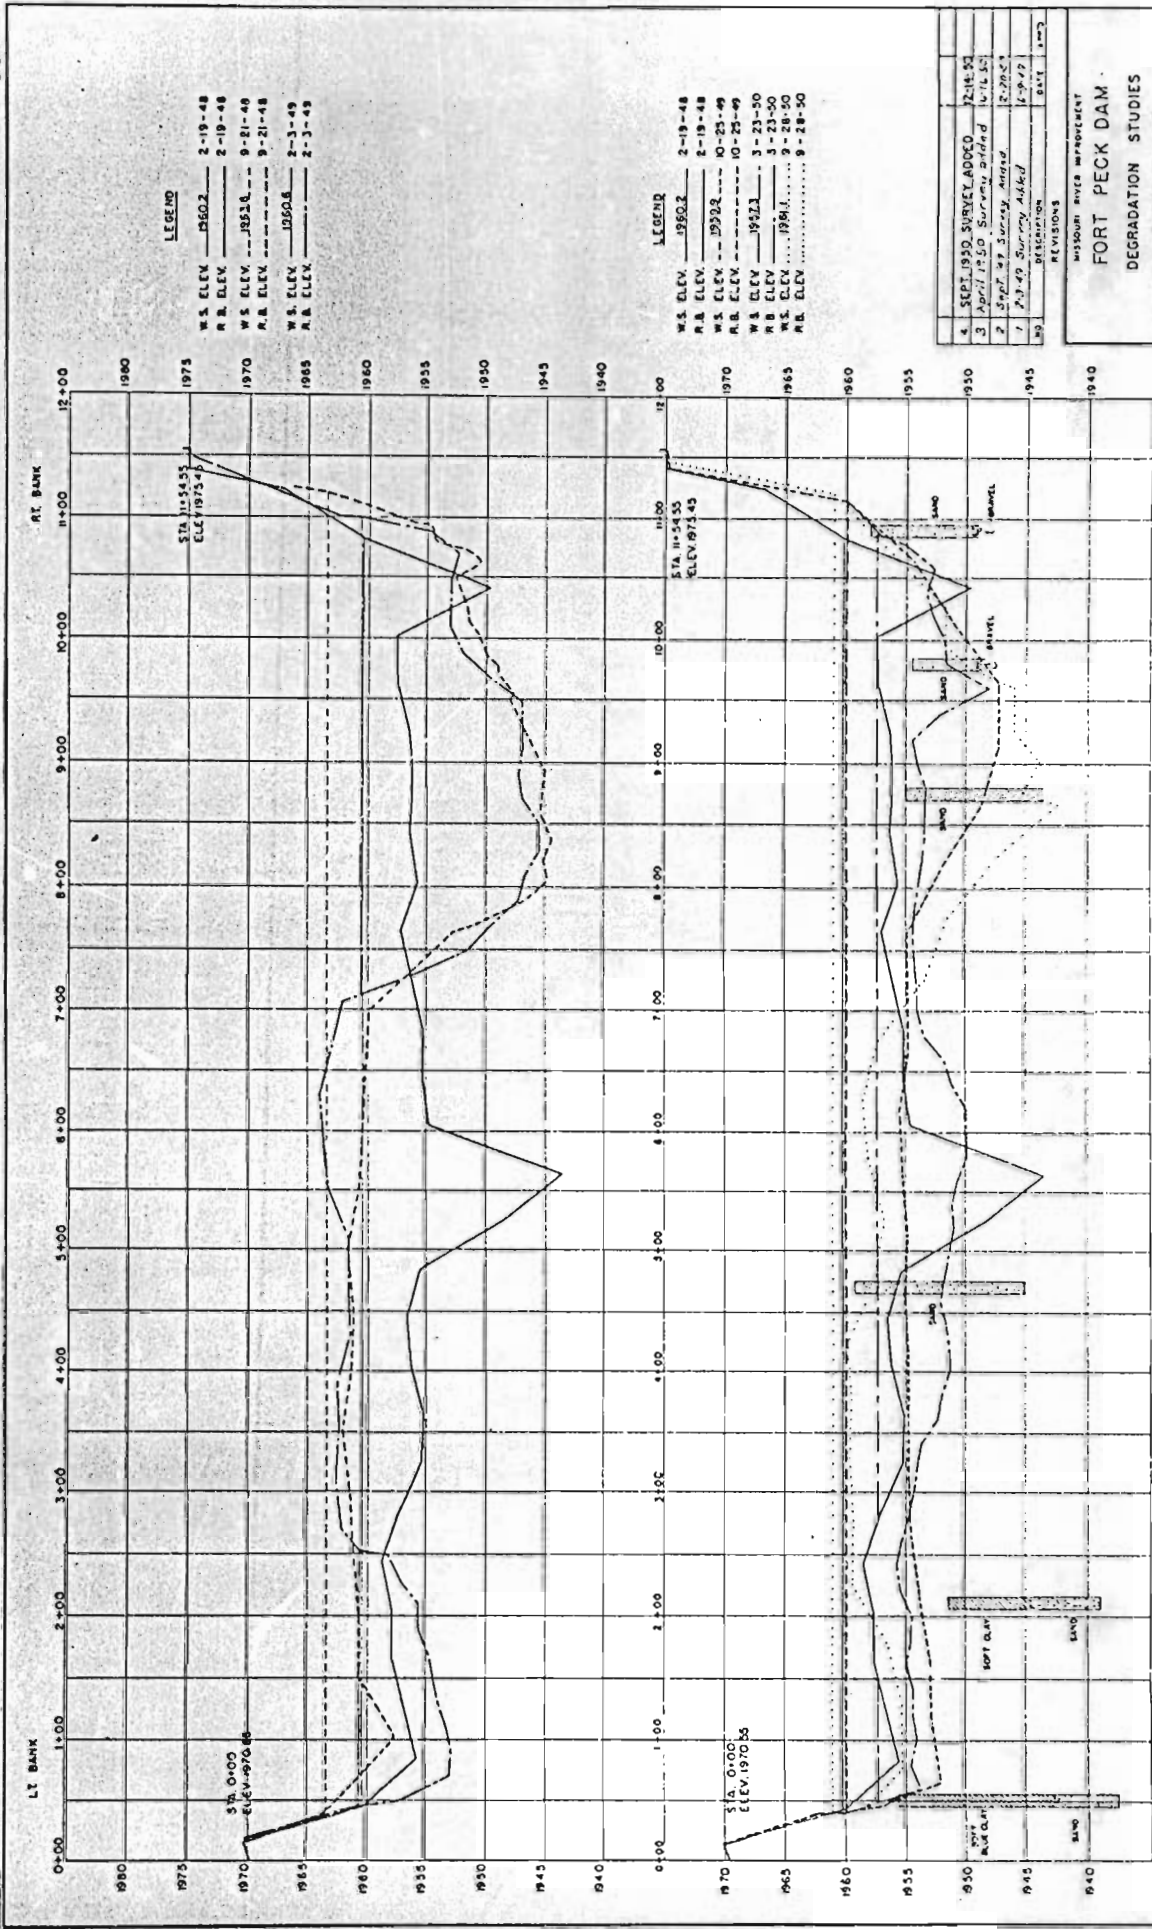


NOTE: SECTION SETTING ON 11 AUG 1950

WS - WATER SURFACE
RB - RIVER BED

MISSOURI RIVER IMPROVEMENT
FORT PECK DAM
DEGRADATION STUDIES
RANGE TWELVE

NO. SHEETS
FORT PECK DISTRICT, FORT PECK, MONTANA

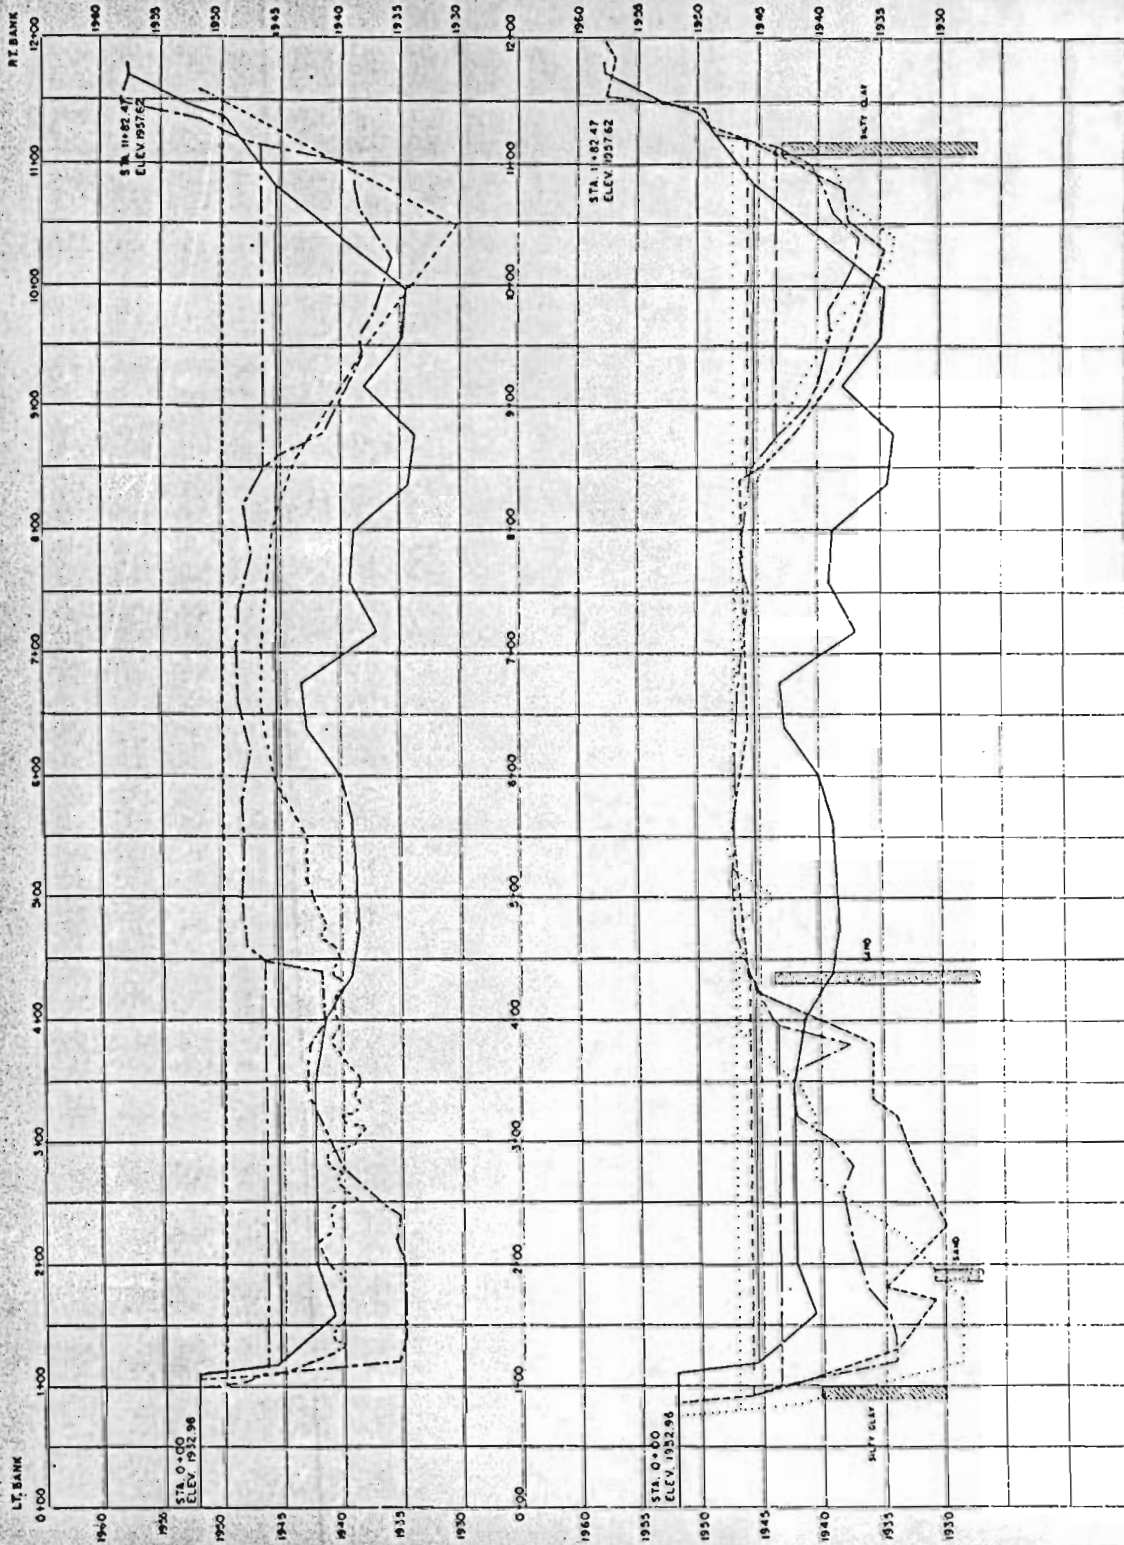

NOTE: SECTION ADDED ON 28 AUG 1960


WS - WATER SURFACE
RB - RIVER BED

1	2-4-19 SURVEY ADDED	6-9-48
0	DISCUSSION	BUL 12/3
REVISIONS		


NO. SHEETS RANGE THIRTEEN SHEET NO.

FORT PECK DISTRICT, FORT PECK, MONTANA

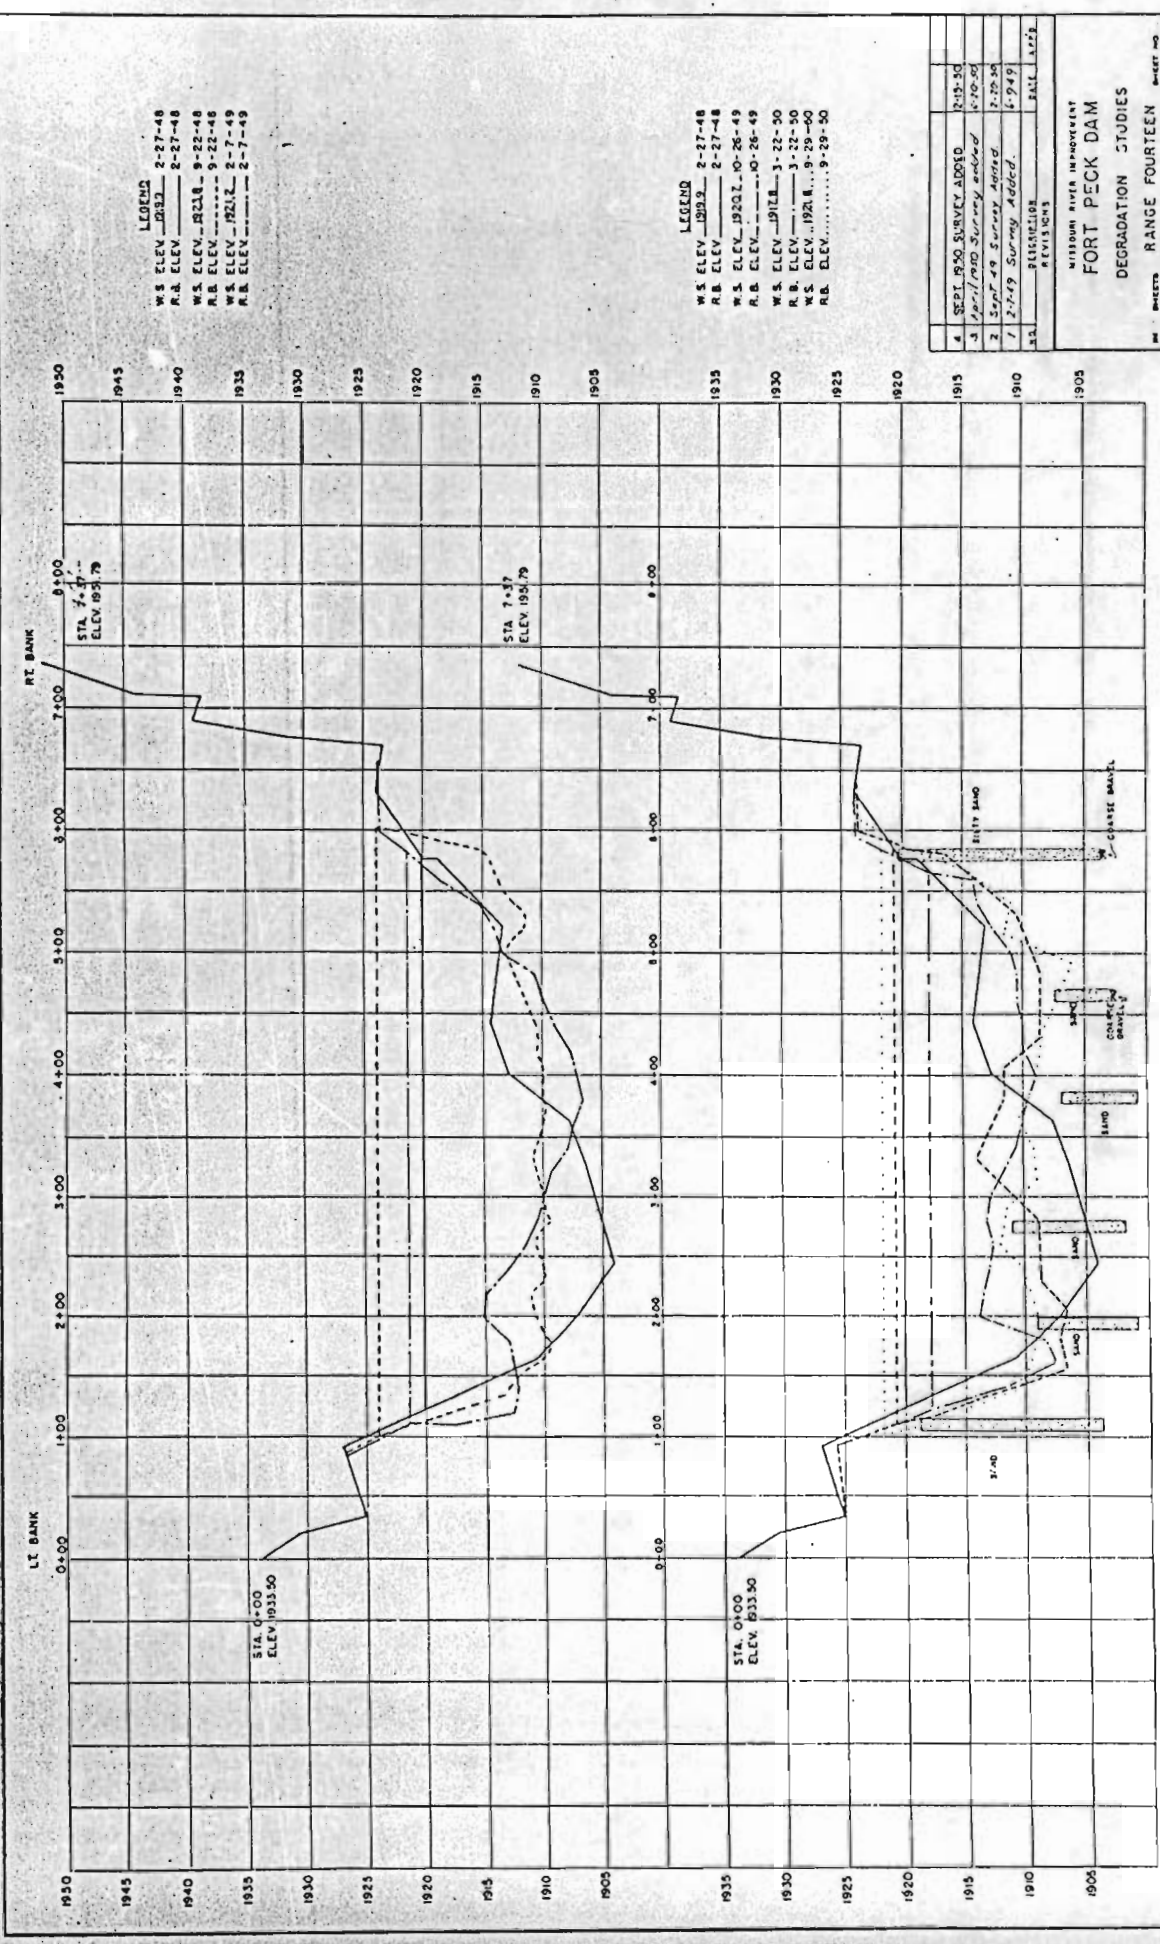

LEGEND



4	SEPT. 1950 SURVEY ADDED	2-15-50
3	APR. 1950 SURVEY ADDED	2-15-50
2	SEPT. 49 SURVEY ADDED	2-20-50
1	2-1-49 SURVEY ADDED	6-9-49
0	ORIGINAL	2-15-48

FORT PECK DAM	
DEGRADATION STUDIES	
RANGE FOURTEEN	
SHEET NO.	
PROJECT NO.	
DRAWN BY	
CHECKED BY	
DATE	
72504-2-8	

WS = WATER SURFACE
RB = RIVER BED

NOTE: RECORD SETTED ON AUG. 25, 1950

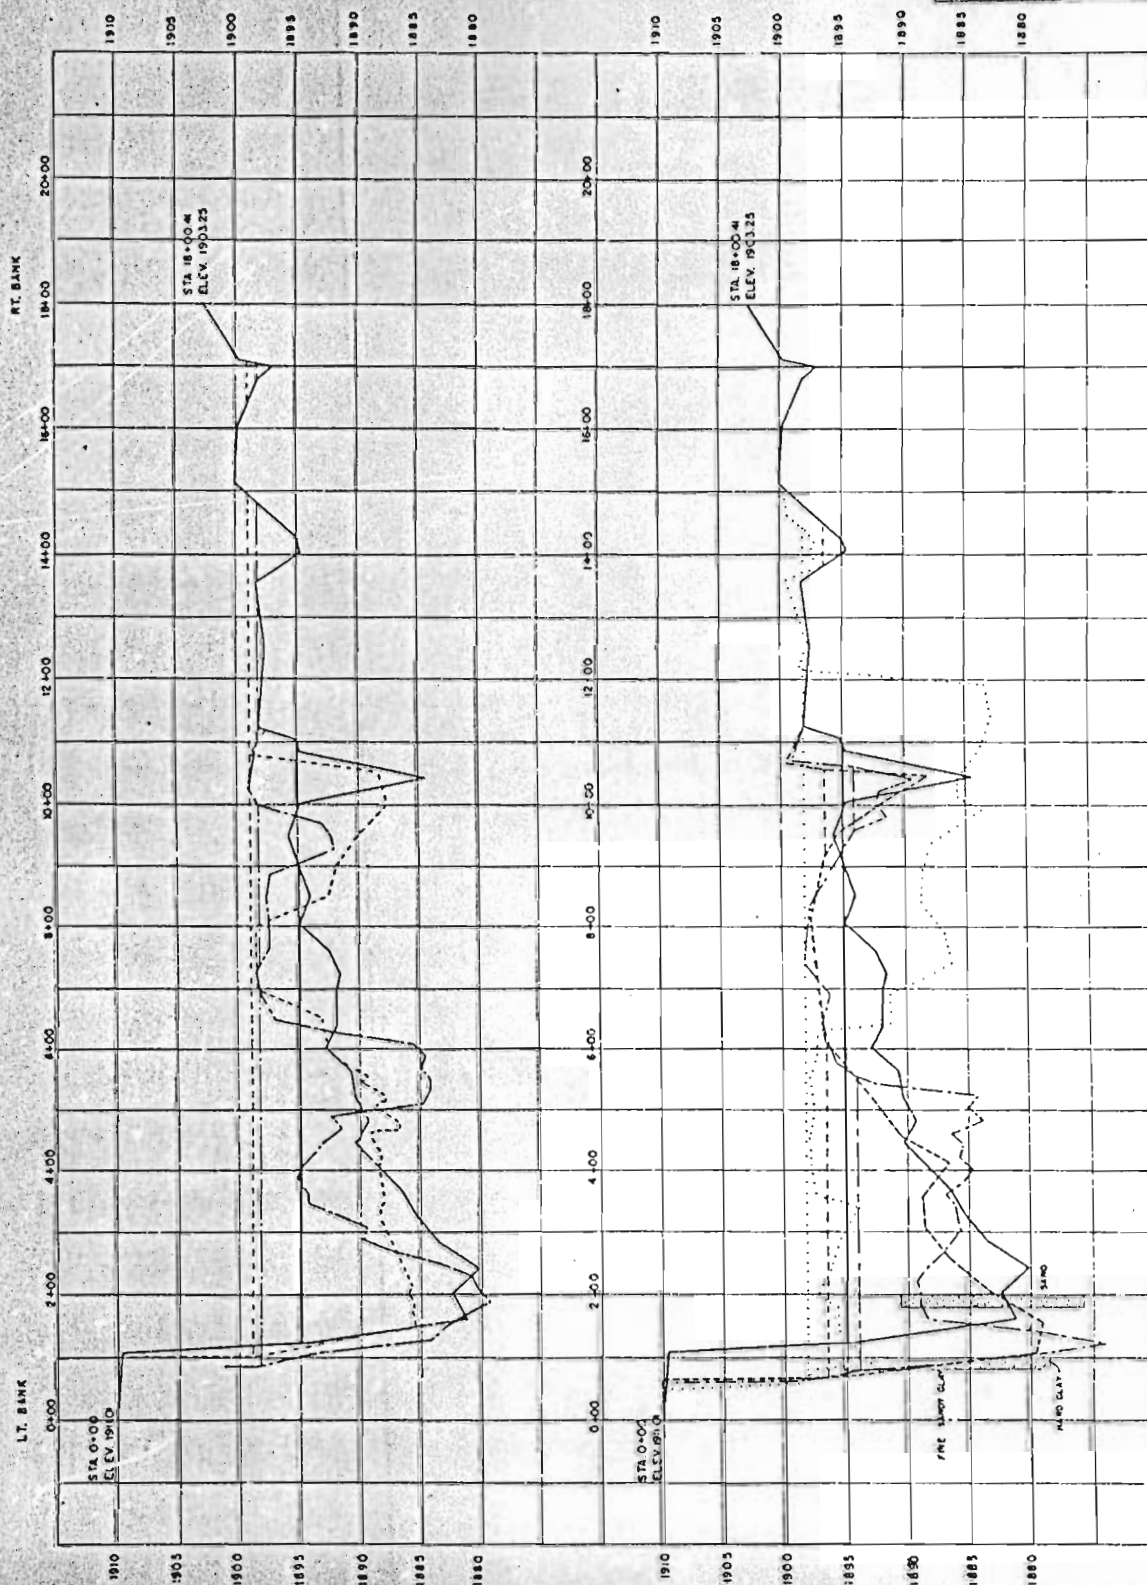

LEGEMO

W. S. ELEV. 1694.3 3-4-48
R. B. ELEV. _____ 3-4-48
W. S. ELEV. 1698.1 9-22-48
R. B. ELEV. _____ 9-22-48
W. S. ELEV. 1692.1 2-8-48
R. B. ELEV. _____ 2-8-48

LEGEND

W.S. ELEV. 1824.9	3-4-48
R.B. ELEV. _____	3-4-48
W.S. ELEV. 1836.5	10-26-49
R.B. ELEV. _____	10-26-49
W.S. ELEV. 1892.9	3-20-50
R.B. ELEV. _____	3-20-50
W.S. ELEV. 1898.2	10-2-50
R.B. ELEV. _____	10-2-50

NO	DESCRIPTION	DATE	DATE
NO			DATE

MISSOURI RIVER IMPROVEMENT
FORT PECK DAM
DEGRADATION STUDIES
RANGE FIFTEEN

RANGE FIFTEEN


FORT PECK DISTRICT, FORT PECK, MONTANA





172504-2-9

100.

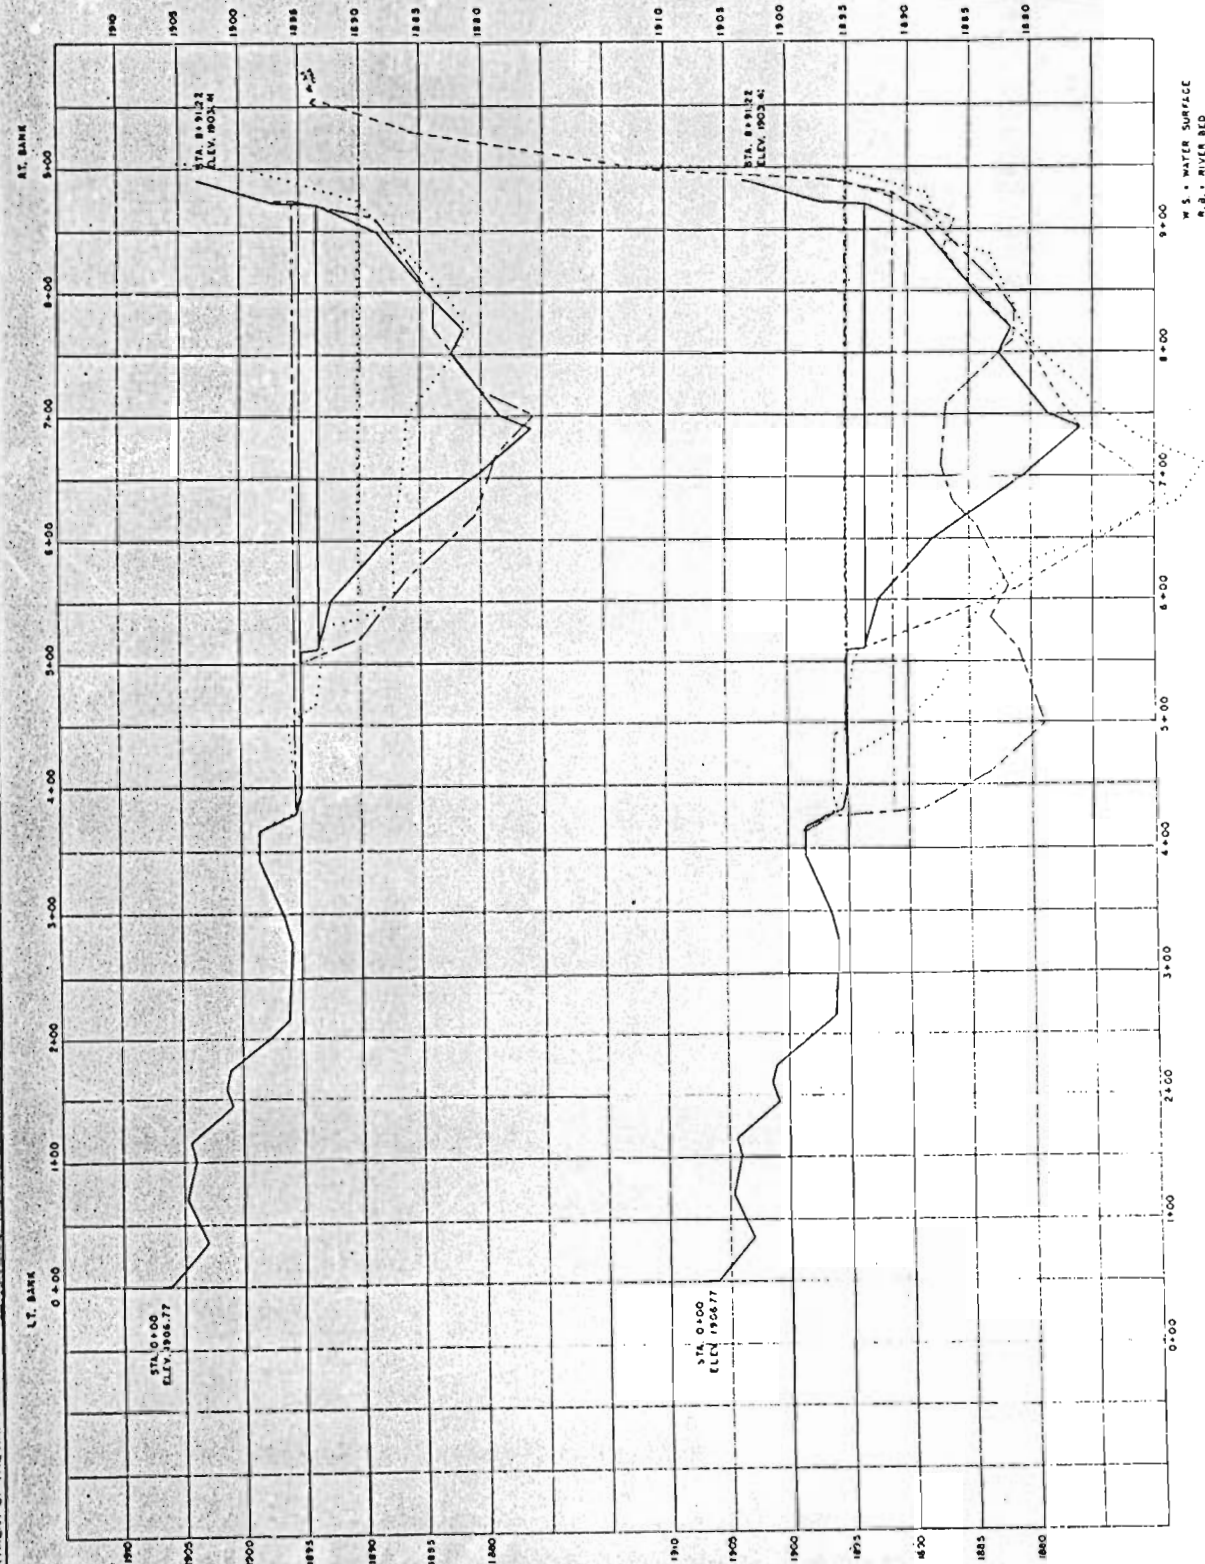


62203

W. S. ZLEV. 1893.4 — 5-9-31
R. S. ZLEV. — 5-9-31
W. S. ZLEV. 1893.7 — 10-9-31
R. S. ZLEV. — 10-9-31
W. S. ZLEV. 1893.8, ... 5-14-32
R. S. ZLEV. 5-14-32

06/20/2017

W. S. ELEV.	1922.4	3-9-54	ORIGINAL
A. B. ELEV.		3-9-54	ORIGINAL
W. S. ELEV.	1922.2	10-8-52	
A. B. ELEV.		10-8-52	
W. S. ELEV.	1921.3	11-13-53	
A. B. ELEV.		11-13-53	
W. S. ELEV.	1921.1	10-6-54	
A. B. ELEV.		10-6-54	

NO.	REV. NO.	DATE
	FORT PECK DAM	
	DEGRADATION STUDIES	
	RANGE 15A	
IN SHEETS	FORT PECK DISTRICT, FORT PECK, MONTANA	SHEET NO.

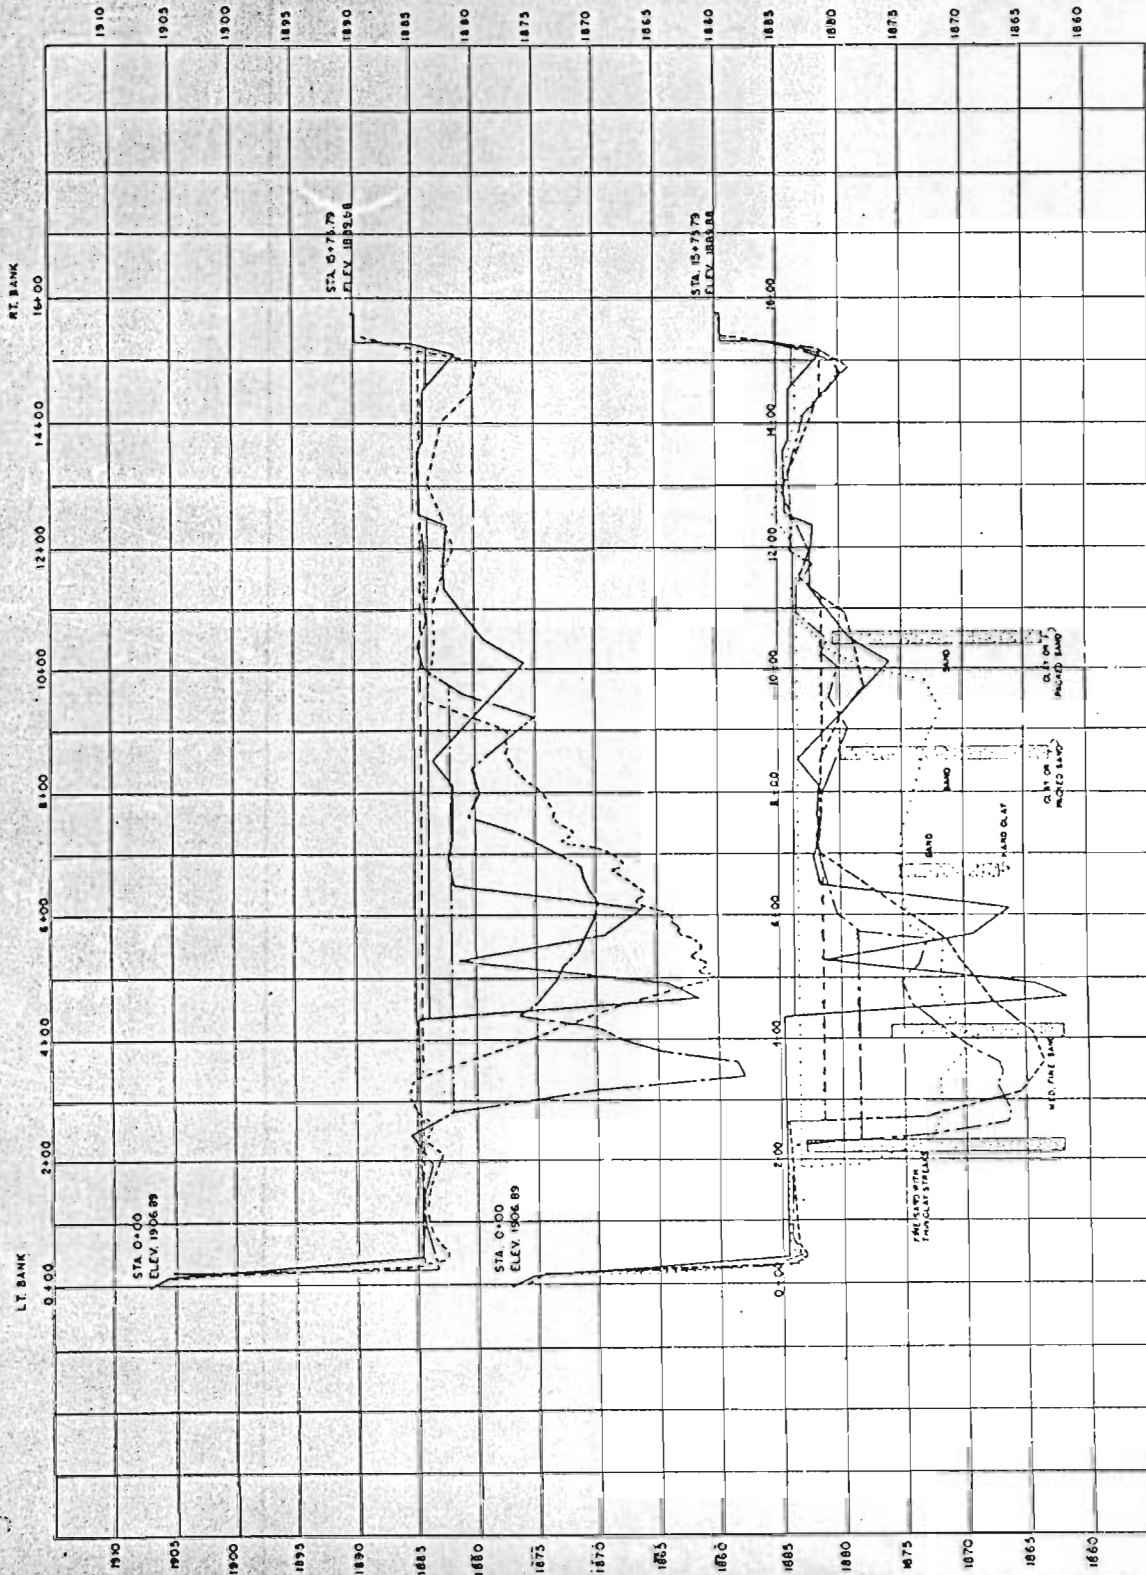

LEGEND
 W.S. ELEV. 1917 3-17-48
 R.B. ELEV. 1917 3-17-48
 W.S. ELEV. 1913 3-22-48
 W.S. ELEV. 1913 3-22-48
 W.S. ELEV. 1913 3-22-48
 R.B. ELEV. 1913 3-22-48




REVISIONS	DATE	BY	APP'D
1	3-17-48	Survey Added	18-50
2	3-22-48	Survey Added	16-100
3	3-22-48	Survey Added	17-100
4	3-22-48	Survey Added	17-100
5	3-22-48	Survey Added	17-100



MISSION RIVER INSPECTION
 FORT PECK DAM
 DEGRADATION STUDIES
 RANGE SIXTEEN
 SHEET NO. 1
 FORT PECK DISTRICT, FORT PECK, MONTANA
 77504-1-98

A.B. = RIVER BED
 W.S. = WATER SURFACE

NOTE: SEE PLAN 17-118 30 AUG 1950

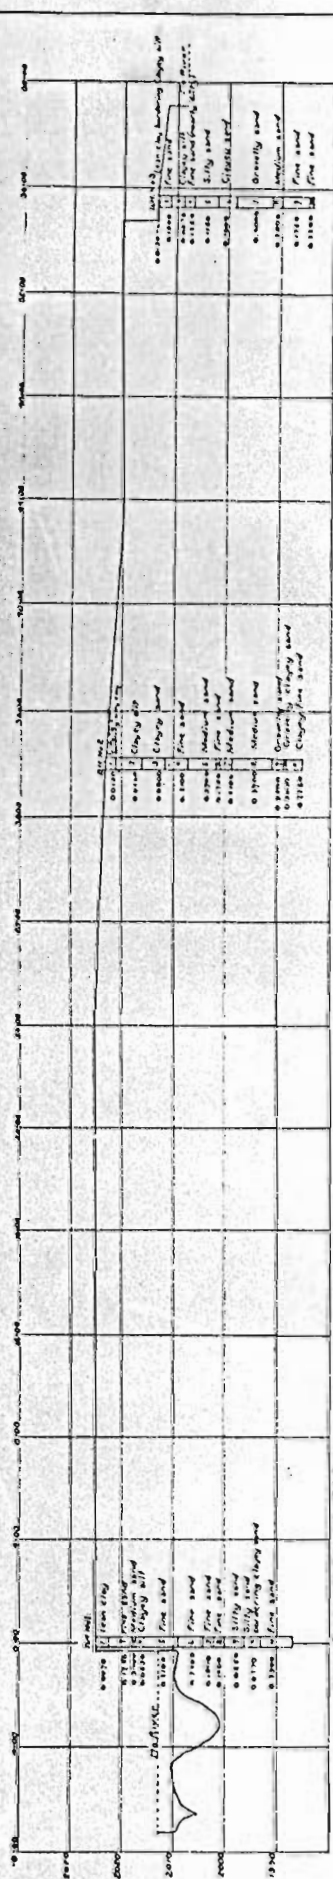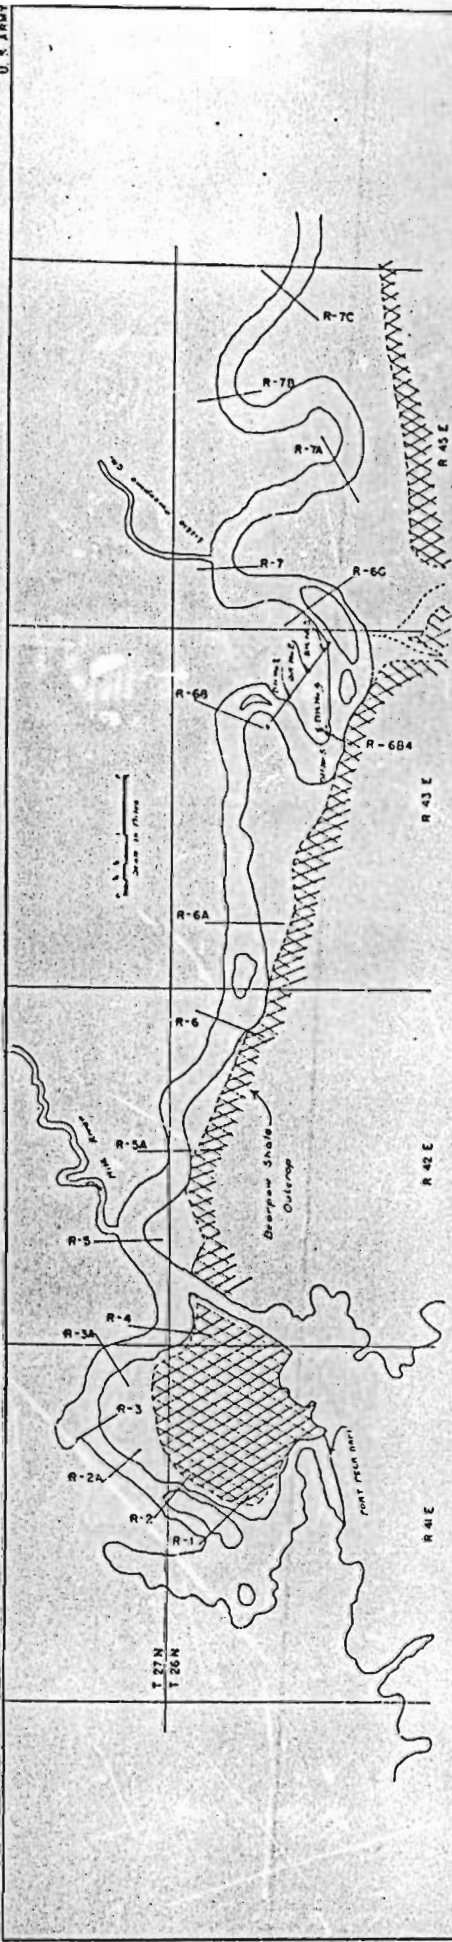

Note, figures edited no left of hole
indicate median size in millimeters.

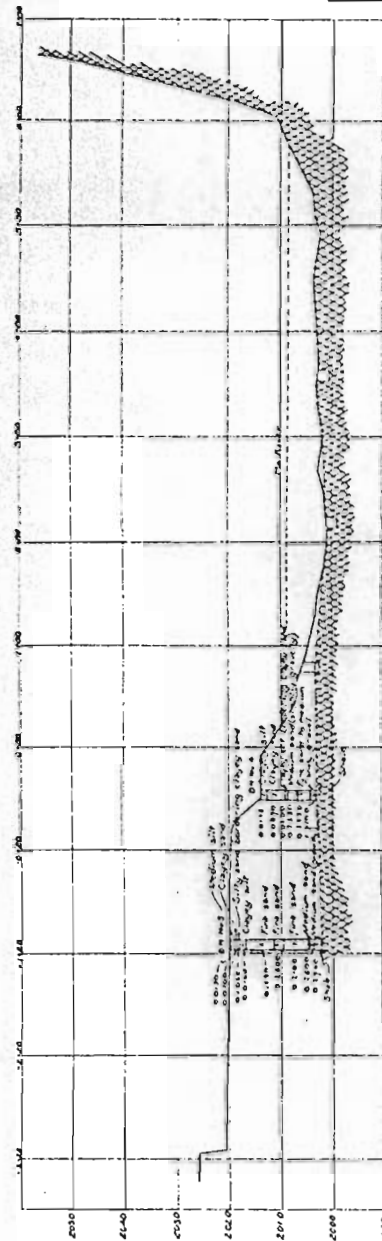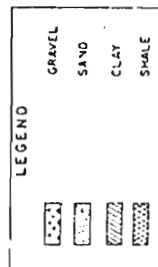[illegible]

WILSON, WALTER ARTHUR (1912)
 FORT PECK DAM
 DEGRADATION STUDIES
 SUBSURFACE INVESTIGATIONS
 RANGE 68-4 AND VICINITY.

1 SHEETS

FORT PECK DISTRICT, FORT PECK, MONTANA

1 SHEETS

7250 4.2-167

[illegible]










01-07-89
01-08-89
01-09-89

MISSOURI, RIVER, IMPROVED
FORT PECK DAM
DEGRADATION STUDIES

STABULATED SUMMARY OF DEGRADATION DATA

100


[illegible]


RECEIVED

72504-2-177








[illegible]

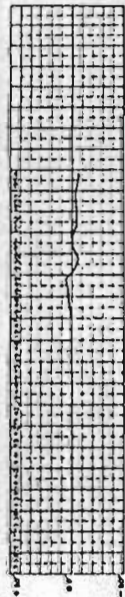


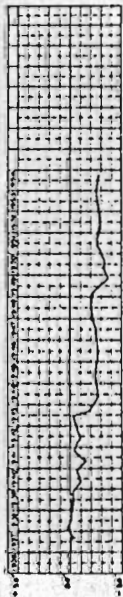



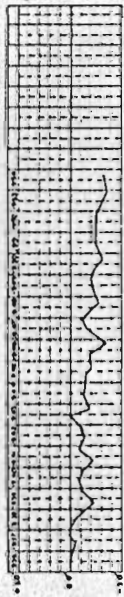







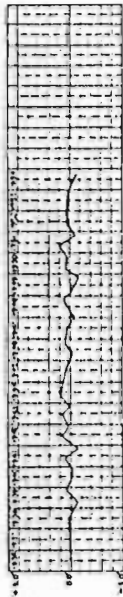


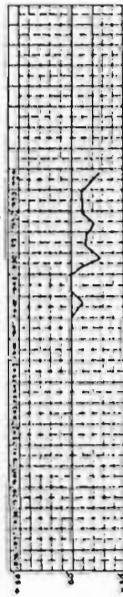



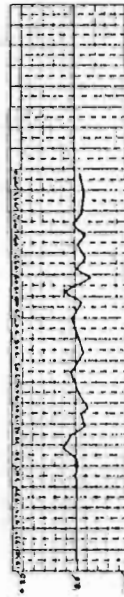






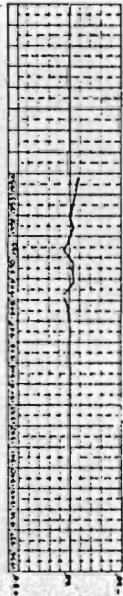







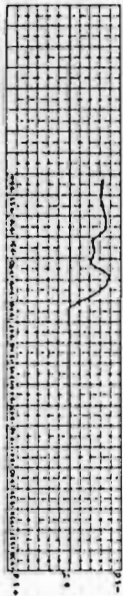


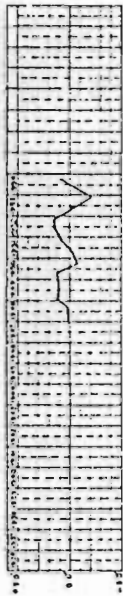



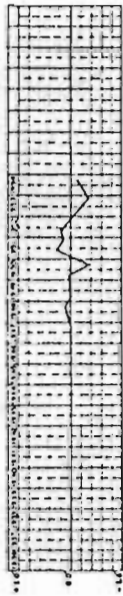






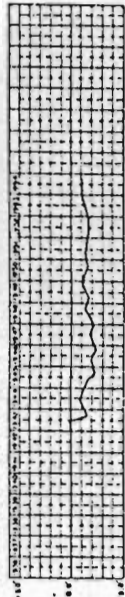







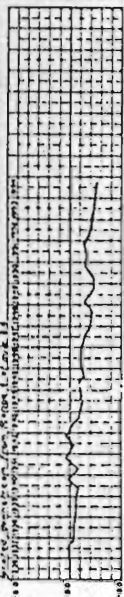



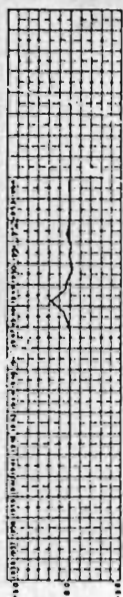

RANGE NO. 18 MILE 16.5

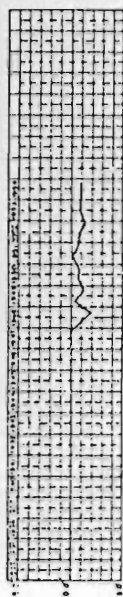

RANGE NO. 19 MILE 17.3

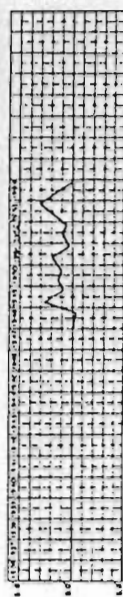

RANGE NO. 20 MILE 18.1
















RANGE NO. 21 MILE 18.9


FORT PECK DAM
DEGRADATION STUDIES
CUMULATIVE BED CHANGES

IN 2 SHEETS
SHEET NO. 1
FORT PECK DISTRICT, FORT PECK, MONTANA
JANUARY 1964
7250.4-2-179

NO.	REVISIONS	DATE	BY
1	ADDED 1.5 MILE (MILE 17.3) TO 18.1	7-15-64	WES
2	REVISIONS		

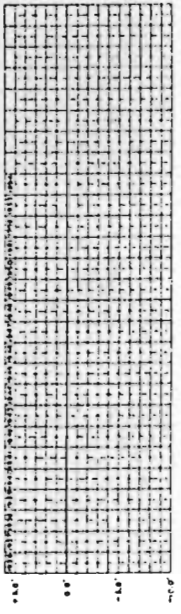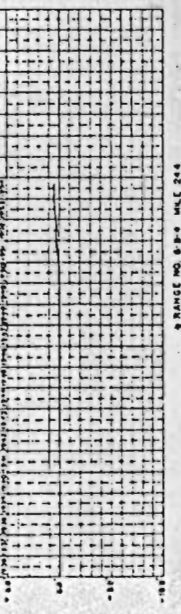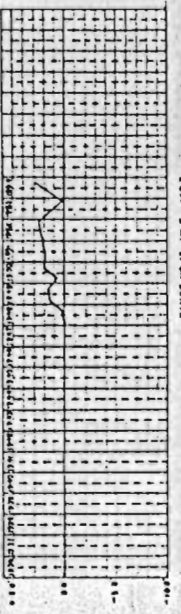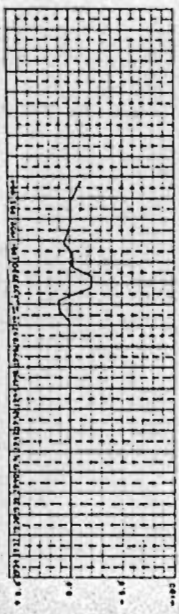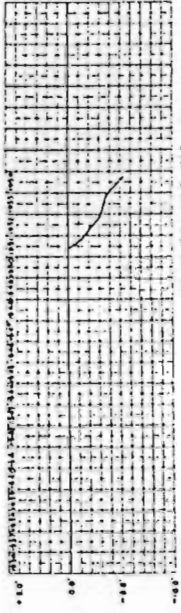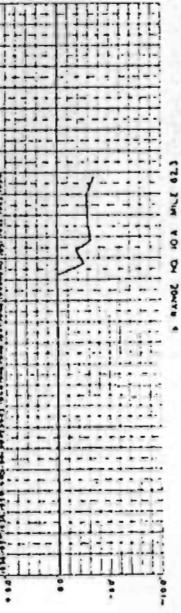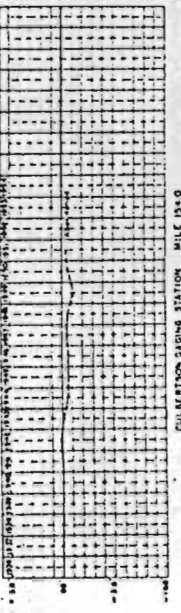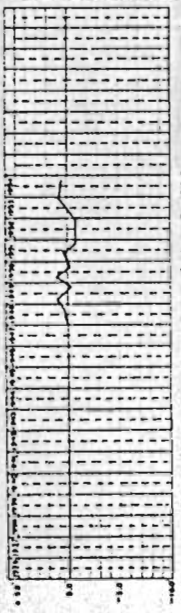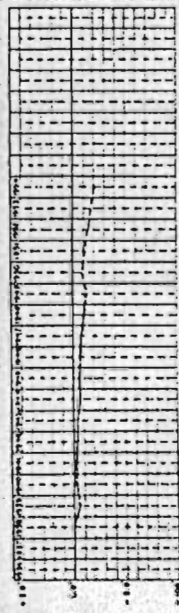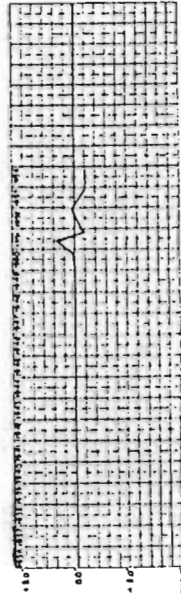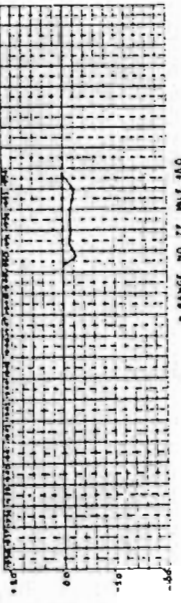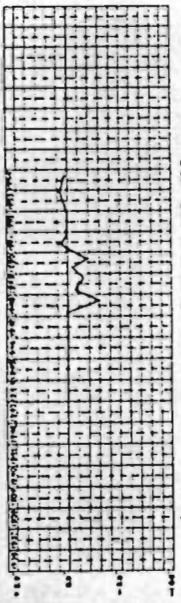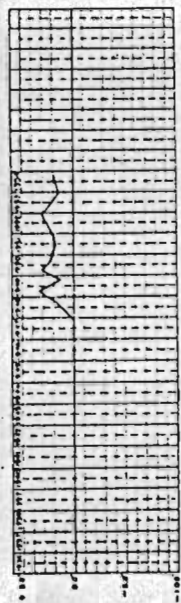

Note: The following had change in the difference in feet between the average bed elevation of the river and the elevation of a mean range of subsequent average bed elevations during same range.

The following had change in the difference in feet between the average bed elevation of the river and the elevation of a mean range of subsequent average bed elevations during same range.

10-A
10-B
10-C
MISSOURI RIVER IMPROVEMENT
FORT PECK DAM
DEGRADATION STUDIES
CUMULATIVE BED CHANGES

NO. 2 SHEETS
SHEET NO. 2

FORT PECK DISTRICT FORT PECK, MONTANA
JULY, 1930

DATE
BY
CHECKED BY
APPROVED BY

7250 4-2-180

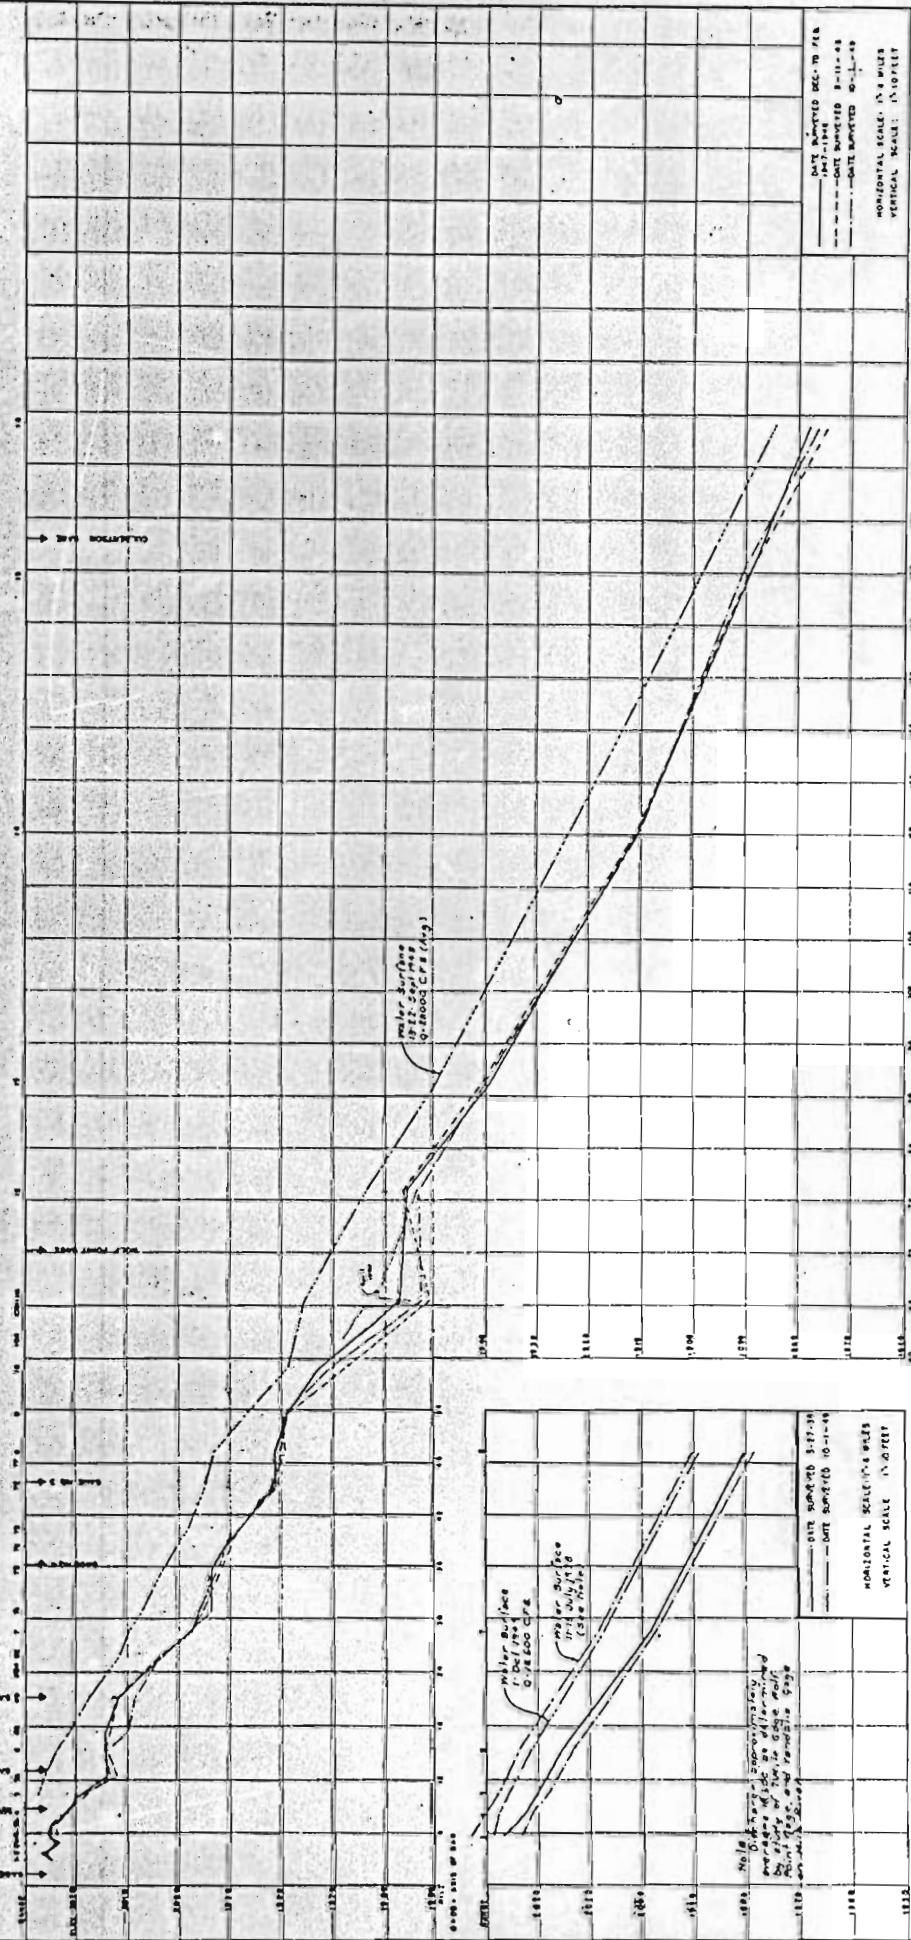

NOTES:
1. Inval above had profile using original
rings established in 1922 and had
survive using same rings as
2. Inval and rings were
104, 108, 110, 112,

MISSOURI RIVER OVERSIGHT
FORT PECK DAM

DEGRADATION STUDIES
RIVER BED PROFILES DOWNSTREAM

FROM FORT PECK DAM


PORT PECK DISTRICT, PORT PECK, MONTANA

72904-2-170

REVISIONS

[illegible]

DATE RECEIVED _____

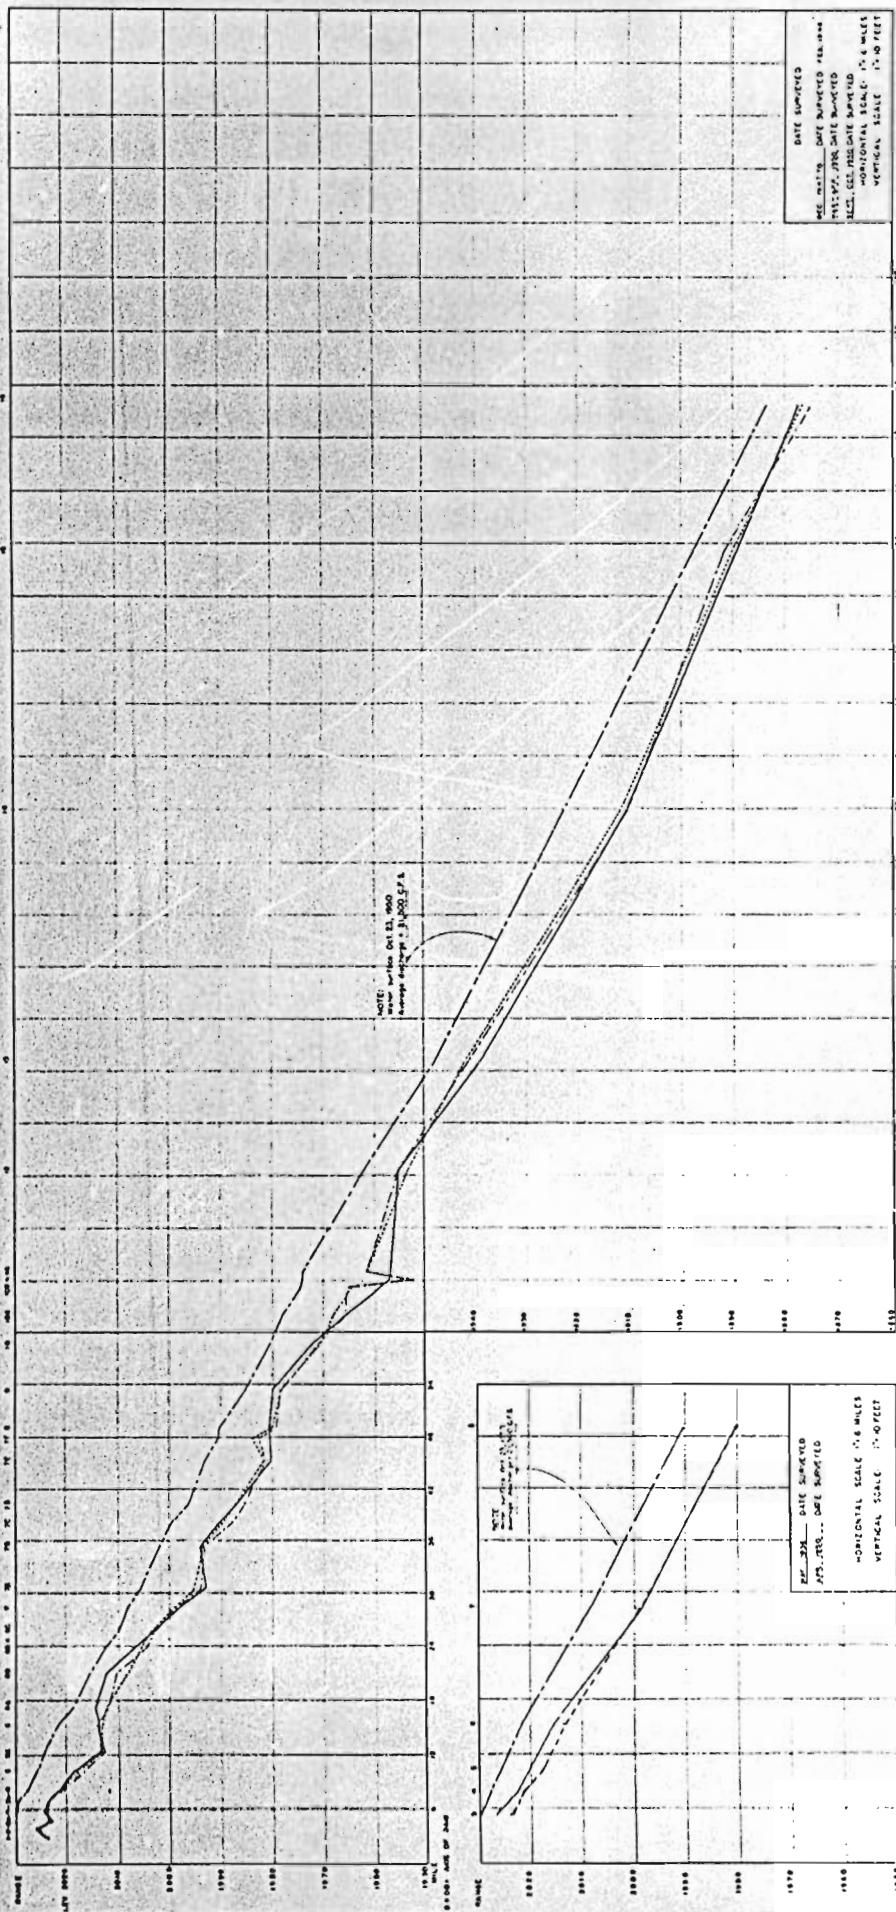


FORT PECK DAM
 DEGRADATION STUDIES
 RIVER BED PROFILES DOWNSTREAM
 FROM FORT PECK DAM
 SHEET NO. 1


NO. 1 SHEETS

FORT PECK DISTRICT FORT PECK, MONTANA
 DEPARTMENT OF THE ARMY
 CORPS OF ENGINEERS

DATE: 10/1/50


1/50-0-4-2-222

[illegible]

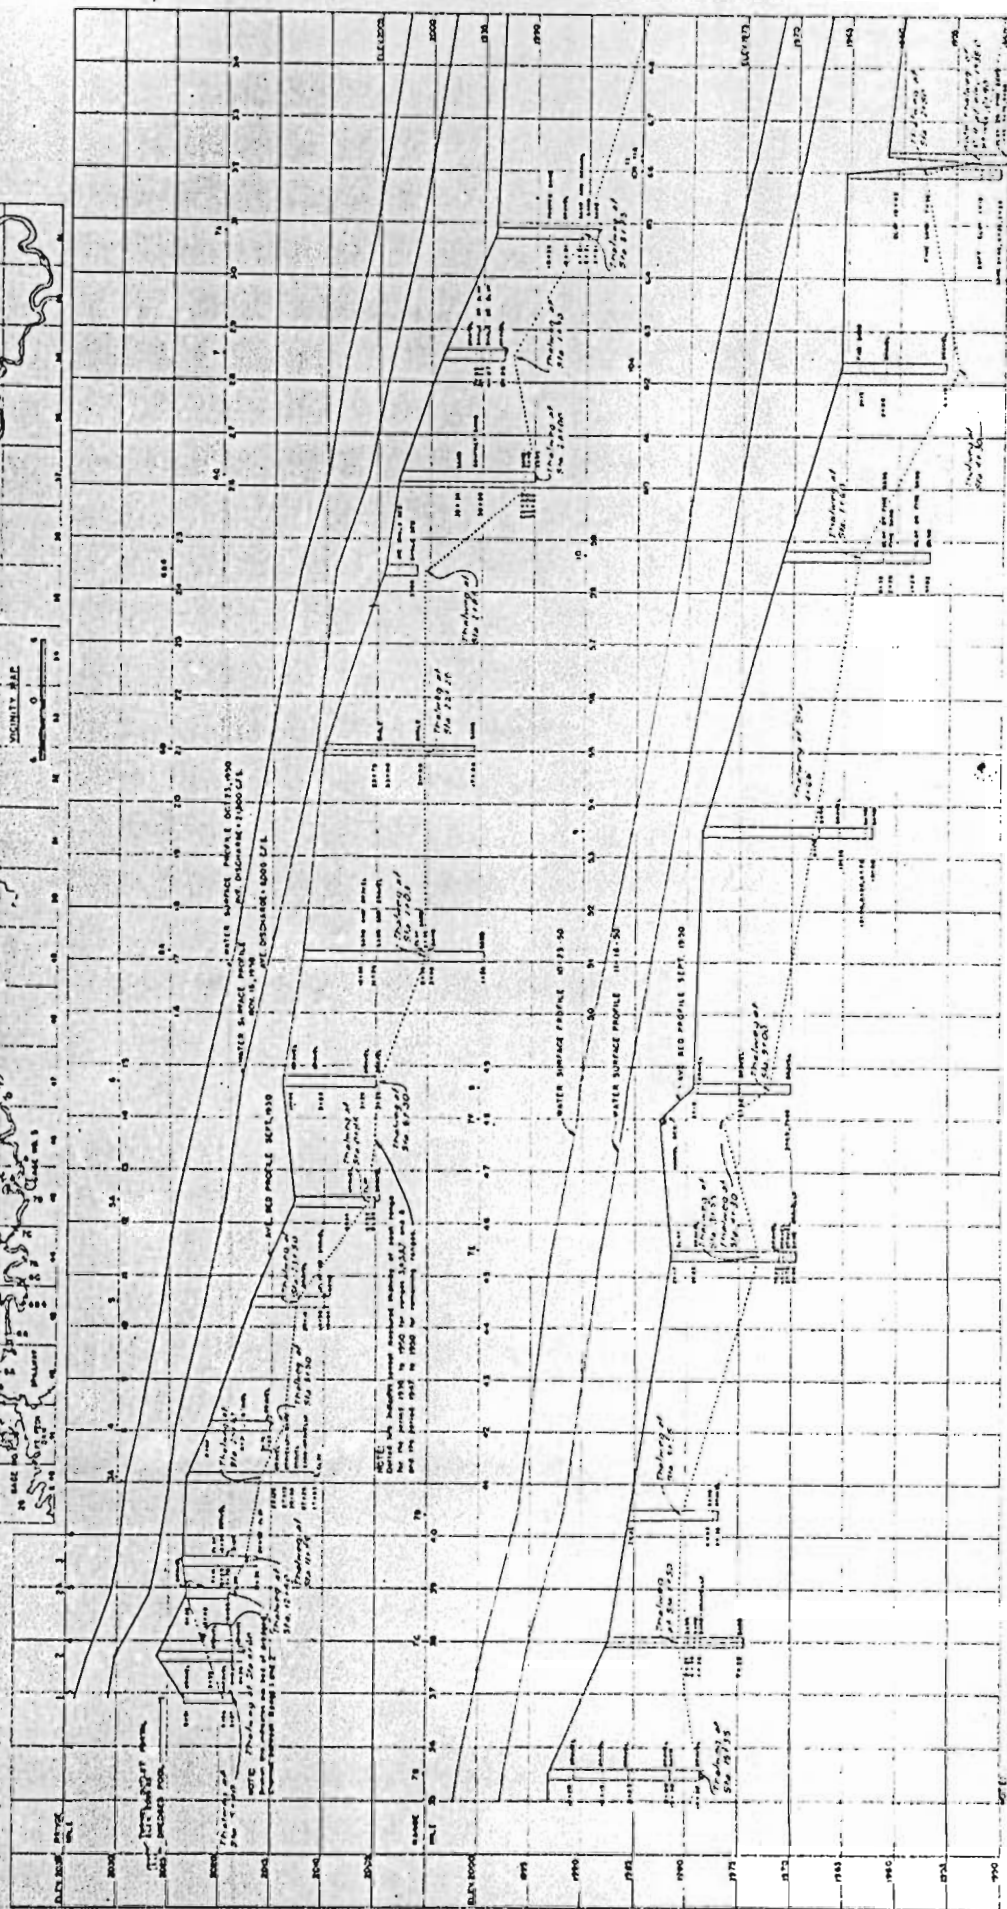[illegible]



100-2
 100-1
 100-3
 100-4
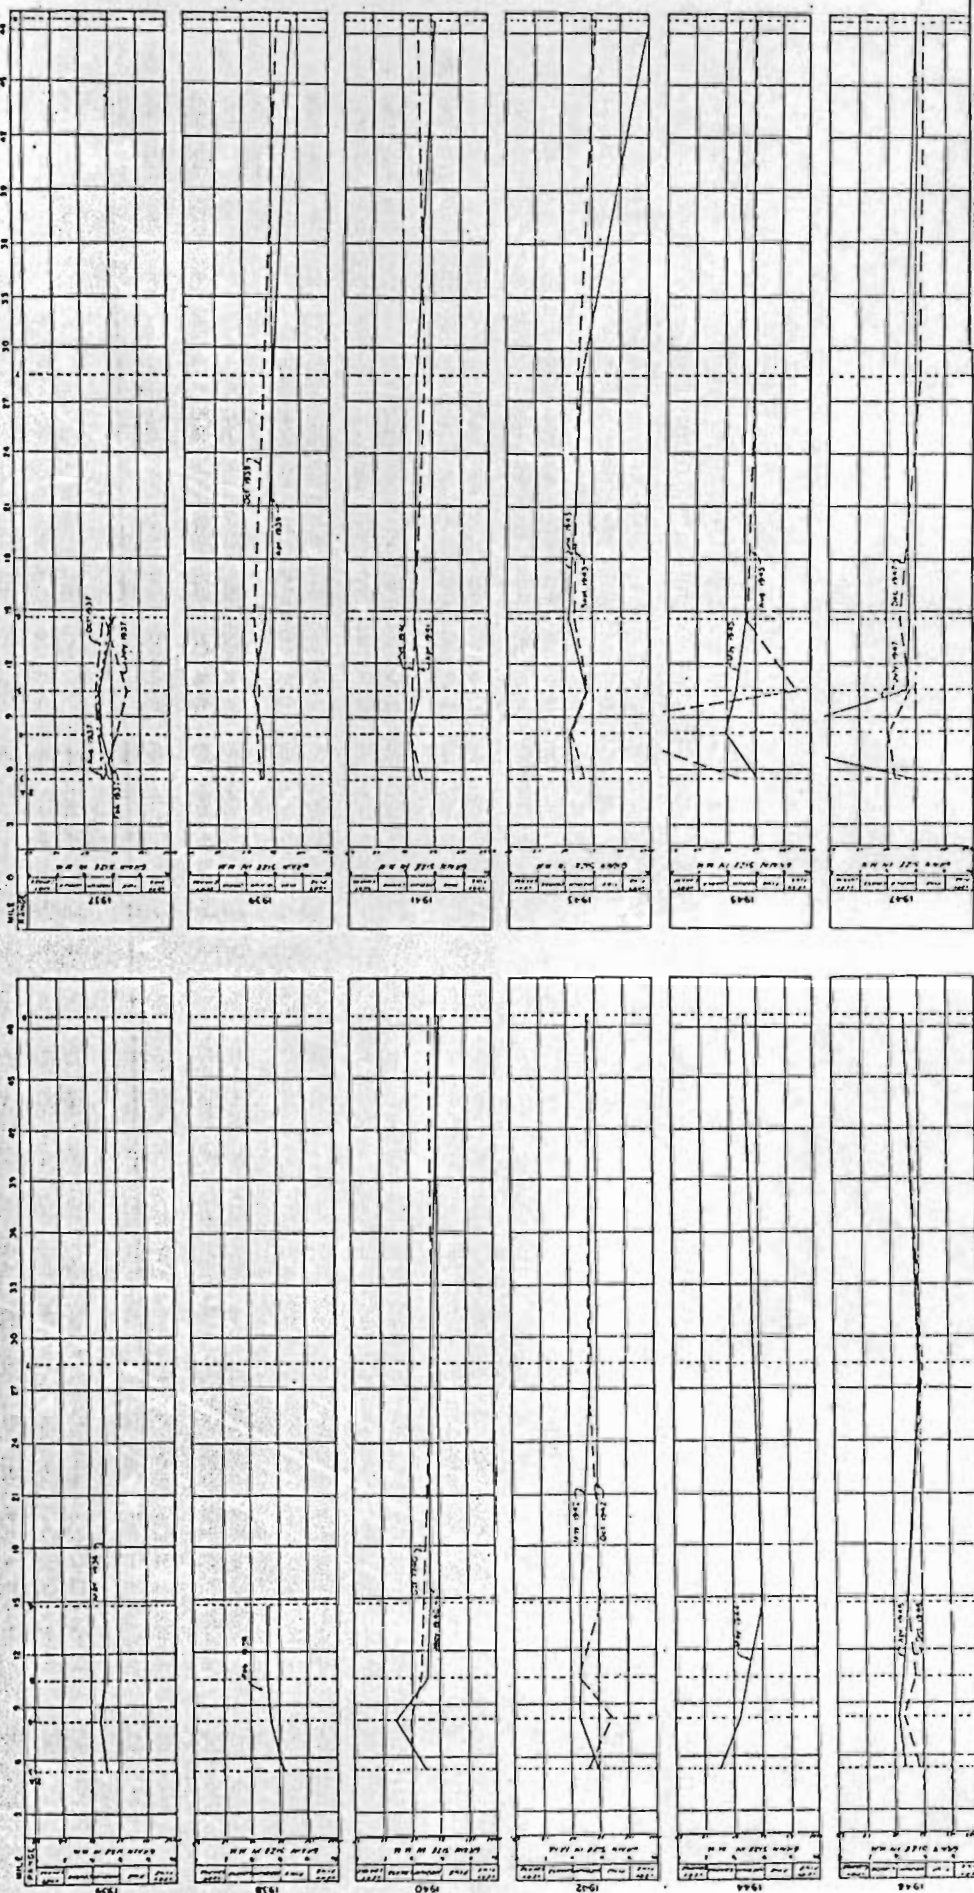

MISSION: WATER IMPROVEMENT
FORT PECK DAM
 DEGRADATION STUDIES
 RANGES 3 TO 8
 ANALYSIS
 MEDIAN
 820 SAMPLES
 1936 TO 1947

NO. 1 SHEETS
 FORT PECK DISTRICT, FORT PECK, MONTANA
 DATE 1952
 7250.4-2-1-53

NO.	REVISIONS	DATE	BY	CHKD.
1	Original	10/3/52	LEB	

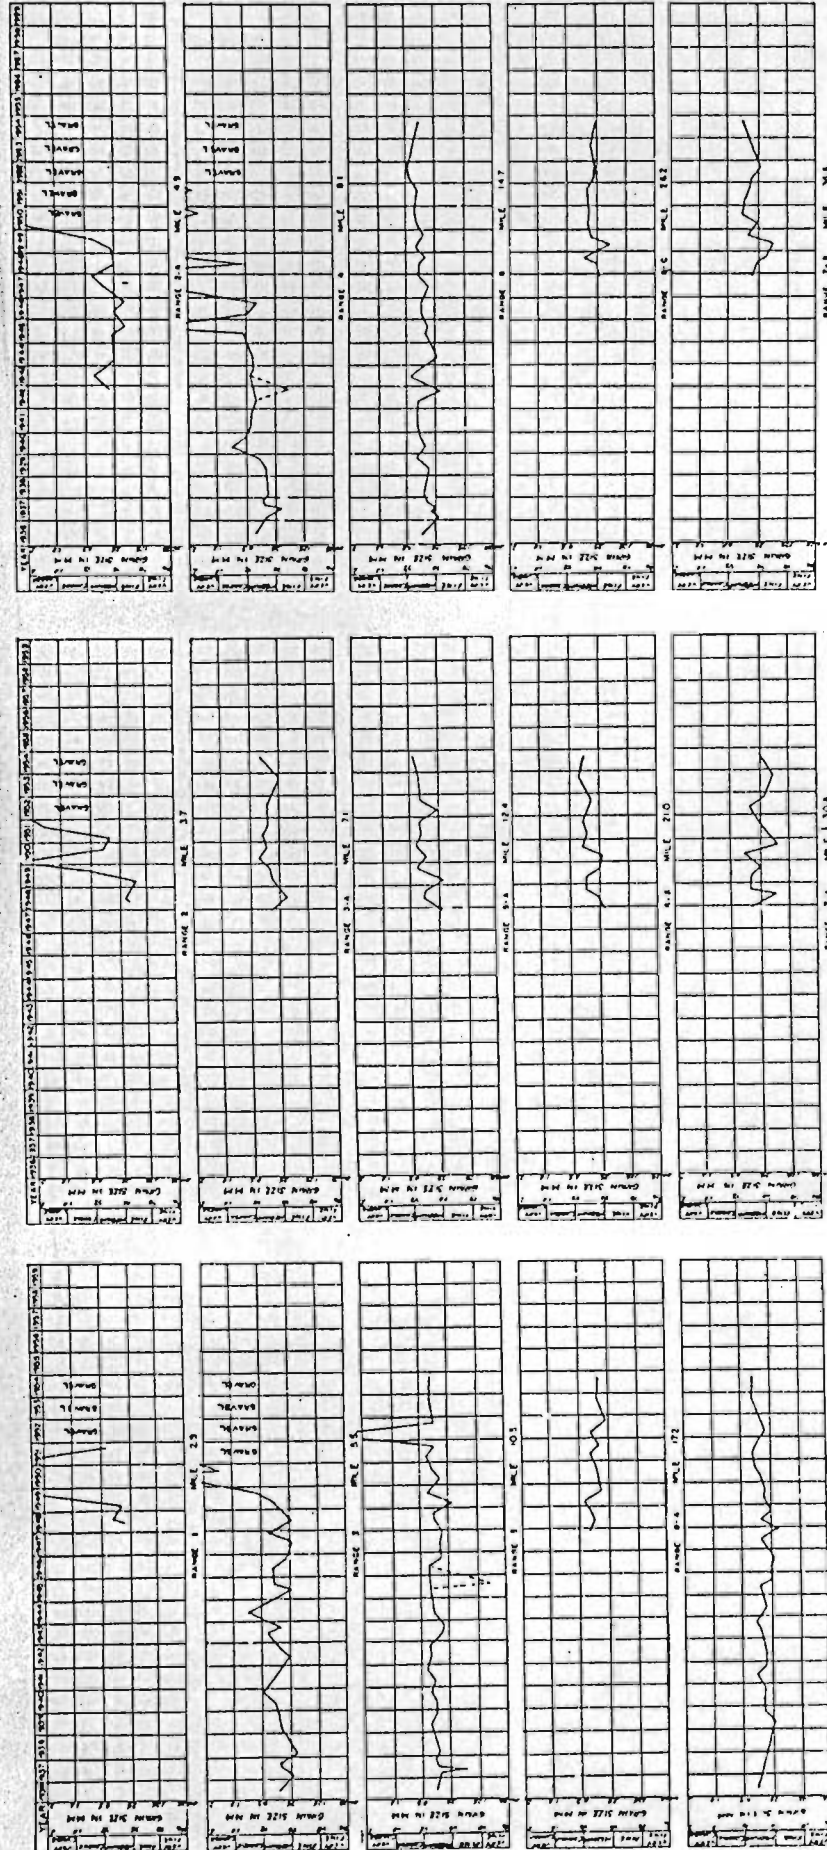

NOTE:

These had samples and standard pictures from 1936 thru 1941.




The samples were taken per range in September 1946.

I got samples used these in October 1948 and from that time forward.


FORT PECK DAM
DEGRADATION STUDIES
MEDIAN SAND SIZE ANALYSES
INDIVIDUAL RANGES

[illegible]

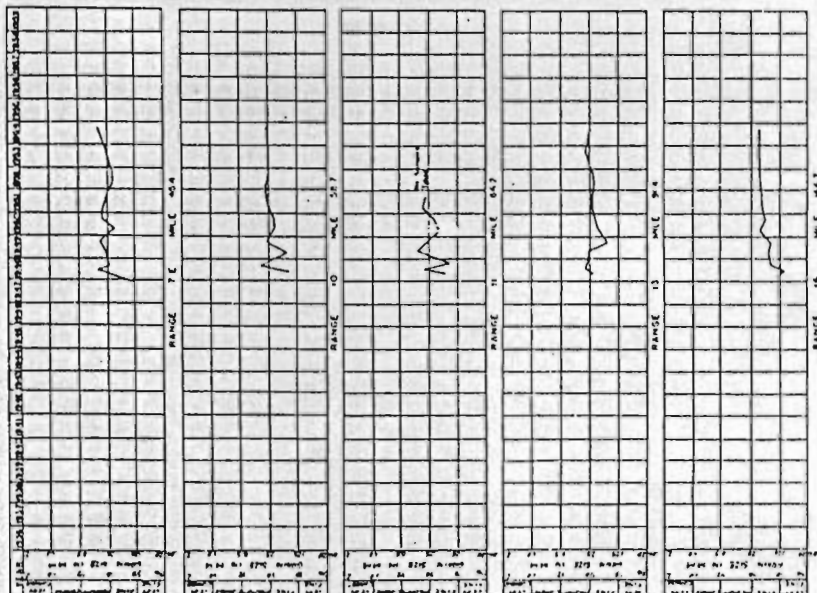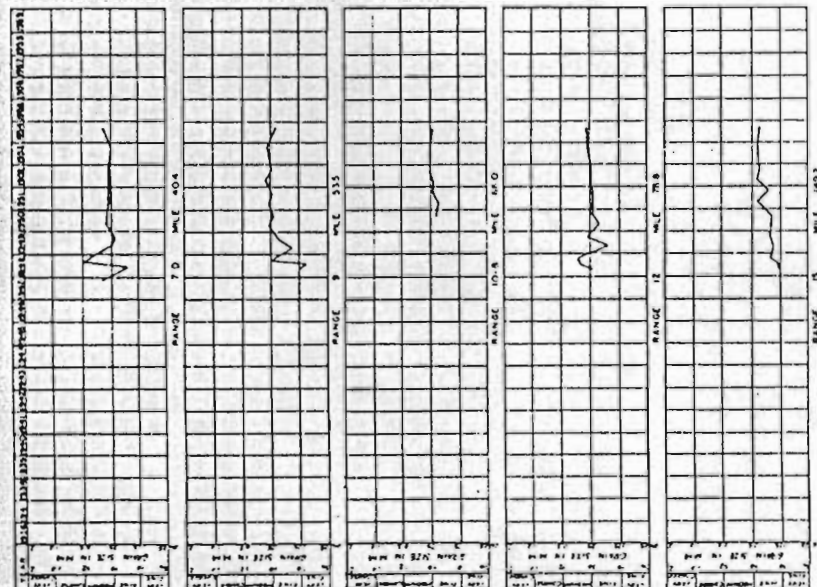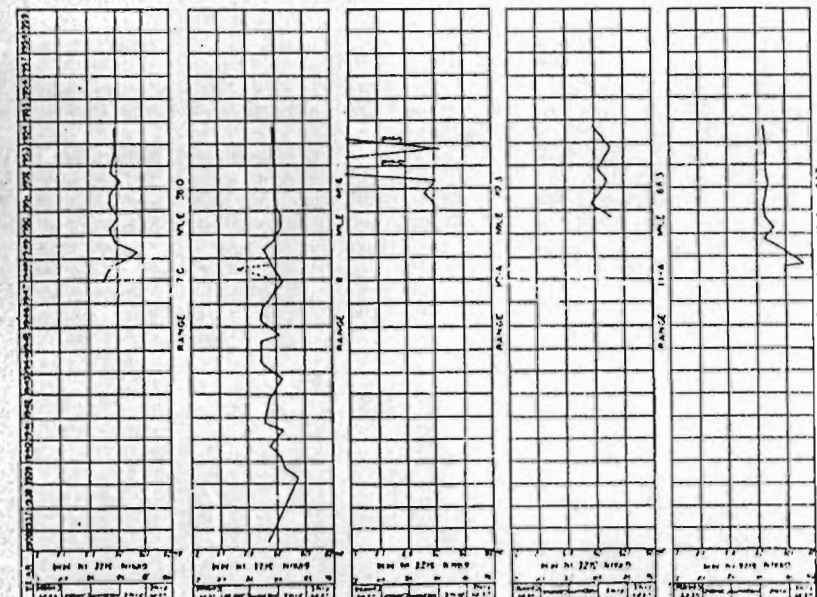

NOTE:


FORT PECK DAM
DEGRADATION STUDIES
MEDIAN SAND SIZE ANALYSES
INDIVIDUAL RANGES





IN 2 SHEETS
SHEET NO. 2

FORT PECK DISTRICT, FORT PECK, MONTANA


7250.4-2-186

[illegible]

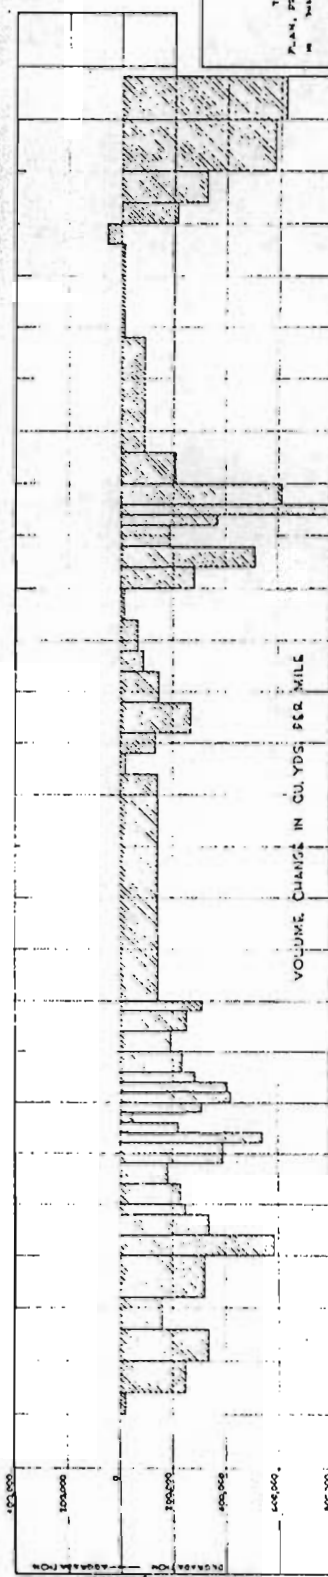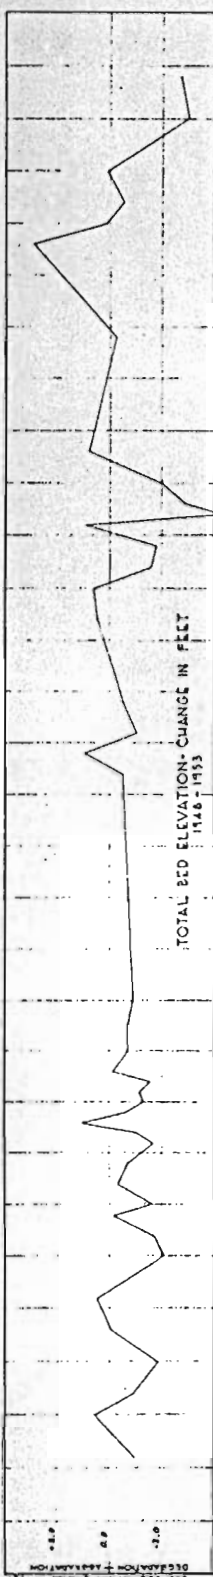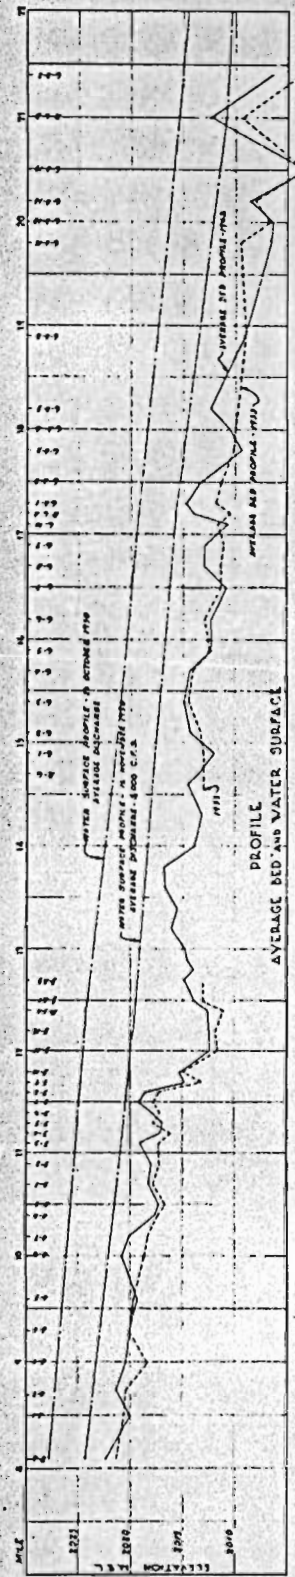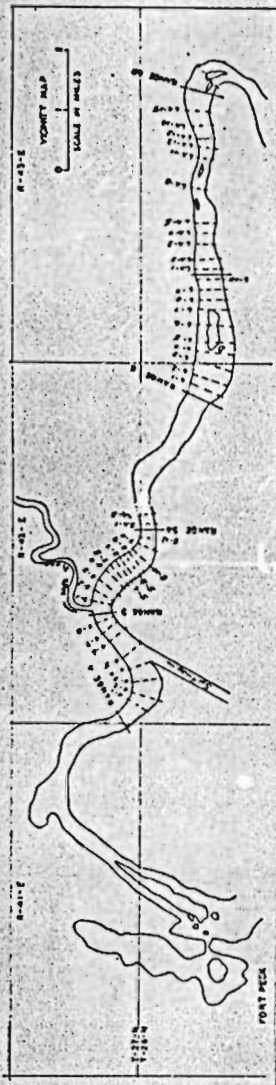

SUMMARY

OCTOBER 1948 TO OCTOBER 1953

Degradation	2,722,000 Cu Yds
Bed Volume Removed	2,111,000 Cu Yds
Total Beach	177 Miles
Volume Removed Per Mile	22,000 Cu Yds
Tunnel Discharge (Cumulative)	10,015,000 A.F.
Spillway Discharge (Cumulative)	10,015,000 A.F.
Mill River Discharge (Cumulative)	1,874,000 A.F.
Total Cumulative Discharge	21,844,000 A.F.
Average River Width (1952)	6,071 Ft.
Average Degradation Per Range	0.59 Ft.

TABULATION OF TEMPERATURE BASED VOLUME COMPUTATIONS



Date of	Volume Change	Cumulative Change
1948 (Original Survey)	0	0
1949	1,004,000	1,004,000
1950	-615,000	389,000
1951	21,000	410,000
1952	415,000	825,000
1953	4,464,000	5,289,000

FORT PECK DAM
 DEGRADATION OBSERVATIONS
 SPECIAL STUDIES
 TEMPORARY RANGES AND A-1 TO C-1
 PLAN, PROFILE, BED ELEVATION CHANGE & VOLUMES
 IN YEARS OCTOBER 1948-OCTOBER 1953 Sheet No. 1

 DATE: 12-20-53

ABULATION OF SUSPENDED SEDIMENT DATA

1871
 1872
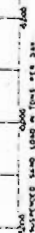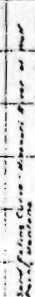

3-1175

PECK DISTRICT, FORT PECK, MONTANA - NOV. 1953

7250.4-2-228


